

**PURCHASER
INFORMATION
BOOKLET
FOR
NORTHVIEW**

PURCHASER INFORMATION BOOKLET

FOR

NORTHVIEW

TABLE OF CONTENTS

PAGE NO.

(NOTE: Documents are separated by colored sheets; page numbers are internal to each document, not consecutive throughout the booklet.)

		<u>Page</u>
CONSOLIDATED MASTER DEED		
	LEGAL DESCRIPTION	1
FIRST	DEFINITIONS	6
	Section 1. Act	6
	Section 2. Association	6
	Section 3. Building Envelope.	6
	Section 4. Bylaws	6
	Section 5. Common Elements	6
	Section 6. Condominium Documents.	6
	Section 7. Condominium Premises	6
	Section 8. Condominium, Condominium Project or Project	6
	Section 9. Condominium Subdivision Plan	6
	Section 10. Construction and Sales Period	6
	Section 11. Co-owner	6
	Section 12. Developer	6
	Section 13. First Annual Meeting	6
	Section 14. Transitional Control Date	7
	Section 15. Unit	7
SECOND	TITLE OF PROJECT	7
THIRD	NATURE OF PROJECT	7
FOURTH	COMMON ELEMENTS	7
	Section 1. General Common Elements	7
	Section 2. Limited Common Elements	8
	Section 3. Responsibilities	8
FIFTH	UNIT DESCRIPTION AND PERCENTAGE OF VALUE	8
	Section 1. Description of Unit	8
	Section 2. Percentage of Value	8
SIXTH	RIGHTS OF MORTGAGEES	8
SEVENTH	DAMAGE TO CONDOMINIUM	9
EIGHTH	EASEMENTS FOR UTILITIES	9
NINTH	EASEMENTS FOR MAINTENANCE	10

		<u>Page</u>
TENTH	ACCESS EASEMENTS RESERVED BY DEVELOPER	10
ELEVENTH	FUTURE EASEMENTS, LICENSES AND RIGHTS-OF-WAY.	10
TWELFTH	ACCESS EASEMENTS	10
THIRTEENTH	AMENDMENT OR TERMINATION	10
FOURTEENTH	ASSIGNMENT	12
 BY-LAWS		
ARTICLE 1	ASSOCIATION OF CO-OWNERS	1
ARTICLE II	ASSESSMENTS	1
Section 1.	Assessments for Common Elements	1
Section 2.	Determination of Assessments	1
Section 3.	Apportionment of Assessments and Penalty for Default	2
Section 4.	Waiver of Use or Abandonment of Unit	2
Section 5.	Enforcement	3
Section 6.	Liability of Mortgagee	4
Section 7.	Developer's Responsibility for Assessments	4
Section 8.	Property Taxes and Special Assessments	4
Section 9.	Personal Property Tax Assessment of Association Property.	4
Section 10.	Mechanic's Lien	4
Section 11.	Statement as to Unpaid Assessments	4
ARTICLE III	ARBITRATION	4
Section 1.	Scope and Election	4
Section 2.	Judicial Relief.	5
Section 3.	Election of Remedies	5
ARTICLE IV	INSURANCE	5
Section 1.	Extent of Coverage	5
Section 2.	Authority of Association to Settle Insurance Claims.	5
Section 3.	Responsibilities of Co-owners	5
Section 4.	Waiver of Right of Subrogation	6
ARTICLE V	RECONSTRUCTION OR REPAIR	6
Section 1.	Responsibility for Reconstruction or Repair	6
Section 2.	Repair in Accordance with Master Deed	6
Section 3.	Association Responsibility for Repair	6
Section 4.	Timely Reconstruction and Repair	6
Section 5.	Eminent Domain	6
Section 6.	Notification of FHLMC	7
Section 7.	Priority of Mortgagee Interests	7

	<u>Page</u>
ARTICLE VI RESTRICTIONS	7
Section 1. Residential Use	7
Section 2. Leasing and Rental	9
Section 3. Architectural Control	10
Section 4. Changes in Common Elements	10
Section 5. Activities	10
Section 6. Pets	10
Section 7. Aesthetics	11
Section 8. Vehicles	11
Section 9. Advertising	11
Section 10. Rules and Regulations	11
Section 11. Right of Access of Association	11
Section 12. Landscaping	12
Section 13. Common Element Maintenance	12
Section 14. Co-owner Maintenance	12
Section 15. Reserved Rights of Developer	12
Section 16. Non-Disturbance Easement Behind Units 215-225	13
Section 17. Special Assessment Project	13
Section 18. Storm Drains in the Rear of Units	13
ARTICLE VII MORTGAGES	13
Section 1. Notice to Association	13
Section 2. Insurance	13
Section 3. Notification of Meetings	13
Section 4. Notice	13
ARTICLE VIII VOTING	14
Section 1. Vote	14
Section 2. Eligibility to Vote	14
Section 3. Designation of Voting Representative	14
Section 4. Quorum	14
Section 5. Voting	14
Section 6. Majority	14
ARTICLE IX MEETINGS	14
Section 1. Place of Meeting	14
Section 2. Annual Meetings	14
Section 3. Special Meetings	15
Section 4. Notice of Meetings	15
Section 5. Adjournment	15
Section 6. Order of Business	15
Section 7. Action Without Meeting	15
Section 8. Consent of Absentees	15
Section 9. Minutes, Presumption of Notice	15
ARTICLE X BOARD OF DIRECTORS	15
Section 1. Number and Qualification of Directors	15
Section 2. Election of Directors	15

	<u>Page</u>
Section 3. Powers and Duties	16
Section 4. Other Duties	16
Section 5. Management Agent	17
Section 6. Vacancies	17
Section 7. Removal	17
Section 8. First Meetings	17
Section 9. Regular Meetings	17
Section 10. Special Meetings	17
Section 11. Waiver of Notice	17
Section 12. Quorum	17
Section 13. First Board of Directors	18
Section 14. Fidelity Bonds	18
 ARTICLE XI OFFICERS	 18
Section 1. Officers	18
Section 2. Election	18
Section 3. Removal	18
Section 4. Duties	18
 ARTICLE XII SEAL	 18
 ARTICLE XIII FINANCE	 19
Section 1. Records	19
Section 2. Fiscal Year	19
Section 3. Bank	19
 ARTICLE XIV INDEMNIFICATION OF OFFICERS AND DIRECTORS	 19
 ARTICLE XV AMENDMENTS	 19
Section 1. Proposal	19
Section 2. Meeting	19
Section 3. Voting by Board of Directors	19
Section 4. Voting by Co-Owners	20
Section 5. When Effective	20
Section 6. Binding	20
Section 7. Notice	20
 ARTICLE XVI COMPLIANCE	 20
 ARTICLE XVII DEFINITIONS	 20
 ARTICLE XVIII REMEDIES FOR DEFAULT	 20
Section 1. Legal Action	20
Section 2. Recovery of Costs	20
Section 3. Removal and Abatement	20
Section 4. Assessment of Fines	20
Section 5. Non-Waiver of Right	21
Section 6. Cumulative Rights, Remedies and Privileges	21
Section 7. Enforcement of Provisions of Condominium Documents	21

ARTICLE XIX RIGHTS RESERVED TO DEVELOPER 21

ARTICLE XX SEVERABILITY 21

REPLAT NO. 7 OF THE CONDOMINIUM SUBDIVISION PLAN

SALINE NORTHVIEW CONDOMINIUM ASSOCIATION CERTIFICATE OF INCORPORATION

SALINE NORTHVIEW CONDOMINIUM ASSOCIATION ARTICLES OF INCORPORATION

ARTICLE I NAME 1

ARTICLE II PURPOSES 1

ARTICLE III BASIS OF ORGANIZATION AND ASSETS 2

ARTICLE IV RESIDENT AGENT 2

ARTICLE V INCORPORATOR 3

ARTICLE VI ACTION BY CONSENT 3

ARTICLE VII MEMBERSHIP AND VOTING 3

ARTICLE VIII LIMITED LIABILITY OF DIRECTORS. 4

ARTICLE IX AMENDMENT 4

CONSOLIDATED MASTER DEED

NORTHVIEW

(Act 59, Public Acts of 1978, As Amended)

THIS CONSOLIDATED MASTER DEED is made and executed on this 18th day of September, 1996, by PETERS BUILDING CO., a Michigan corporation, hereinafter referred to as the "Developer", whose office is situated at 203 W. Michigan Avenue, Saline, Michigan, in pursuance of the provisions of the Michigan Condominium Act as amended (being Section 559.2 of the Compiled Laws of 1948 and Act 59 of the Public Acts of 1978, as amended), hereinafter referred to as the "Act".

WITNESSETH:

WHEREAS, the Developer has established Northview, a condominium, by recording the Master Deed thereof on July 21, 1988, in Liber 2244, Pages 829 through 896, inclusive, as amended by the First Amendment to Master Deed recorded February 9, 1989, in Liber 2295, Pages 173 through 193, inclusive, as amended by the Second Amendment to Master Deed recorded on November 4, 1991, in Liber 2552, Pages 157 through 183, inclusive, as amended by the Third Amendment to Master Deed recorded on March 25, 1993, in Liber 2765, Pages 638 through 670, inclusive, as amended by the Fourth Amendment to Master Deed recorded on May 27, 1994, in Liber 2981, Pages 359 through 395, inclusive, as amended by the Fifth Amendment to Master Deed recorded on July 6, 1994, in Liber 2999, Pages 71 through 87, inclusive, and as amended by the Sixth Amendment to Master Deed recorded on January 27, 1995, in Liber 3075, Pages 214 through 257, inclusive, Washtenaw County Records, and

WHEREAS, the Michigan Condominium Act, as amended, requires that the Developer record a consolidated master deed as the final amended master deed for an expandable condominium project which consolidated master deed fully describes the condominium project as completed, and

WHEREAS, the real property that the Developer has submitted to Northview as established by this Consolidated Master Deed is located in the City of Saline, County of Washtenaw, Michigan, and more particularly described as follows:

Commencing at the W 1/4 Corner of Section 36, T3S, R5E, City of Saline, Washtenaw County, Michigan; thence S89°17'34"E 927.78 feet along the

E-W 1/4 line of said section and the centerline of Saline-Waterworks Road; thence N1°30'20"W 43.03 feet for a Place of Beginning; thence N89°17'34"W 328.00 feet; thence N0°42'26"E 127.00 feet; thence 10.91 feet along the arc of a circular curve to the right, radius 1467.00 feet, chord bearing N0°55'13"E 10.91 feet; thence S82°47'14"E 57.52 feet; thence 266.56 feet along the arc of a circular curve to the left, radius 1751.86 feet, chord bearing S87°08'47"E 266.31 feet; thence S1°30'20"E 121.51 feet along the west line of Colony Estates as recorded in Liber 21 of Plats, Pages 84-86, Washtenaw County Records, to the Place of Beginning, being a part of the NW 1/4 of said Section 36 and containing 0.94 acres of land more or less (Units 1-3).

Commencing at the W 1/4 Corner of Section 36, T3S, R5E, City of Saline, Washtenaw County, Michigan; thence S89°17'34"E 200.00 feet along the E-W 1/4 line of said section and the centerline of Saline-Waterworks Road; thence N1°35'00"E 43.00 feet for a Place of Beginning; thence continuing N1°35'00"E 392.60 feet; thence N89°17'45"W 200.00 feet; thence N1°35'00"E 2006.45 feet along the west line of said Section 36; thence S89°28'10"E 150.00 feet; thence S01°35'00"W 129.39 feet; thence 315.13 feet along the arc of a 444.91 foot radius circular curve to the left, having a chord which bears S18°42'31"E 308.59 feet; thence S39°00'00"E 397.70 feet; thence 3.18 feet along the arc of a 583.00 foot radius circular curve to the left, having a chord which bears S39°09'23"E 3.18 feet; thence non-tangentially S47°26'30"W 113.20 feet; thence 942.00 feet along the arc of a 1035.13 foot radius circular curve to the left, having a chord which bears S21°22'17"W 909.83 feet; thence 471.54 feet along the arc of a 283.00 foot radius circular curve to the left, having a chord which bears S52°25'59"E 418.86 feet; thence N79°50'00"E 46.19 feet; thence 145.58 feet along the arc of a 717.00 foot radius non-tangential circular curve to the right, having a chord which bears S06°11'56"E 145.33 feet; thence 125.67 feet along the arc of a 1467.00 foot radius circular curve to the right, having a chord which bears S02°04'20"W 125.63 feet; thence 17.54 feet along the arc of a 1533.00 foot radius circular curve to the left, having a chord which bears S04°11'55"W 17.54 feet; thence non-tangentially N82°47'14"W 65.85 feet; thence 51.73 feet along the arc of a 75.00 foot radius circular curve to the right, having a chord which bears N63°01'42"W 50.71 feet; thence 293.87 feet along

the arc of a 65.00 foot radius circular curve to the left, having a chord which bears S07°12'46"W 100.29 feet; thence 51.73 feet along the arc of a 75.00 foot radius circular curve to the right, having a chord which bears N77°27'14"E 50.71 feet; thence S82°47'14"E 71.13 feet; thence 18.43 feet along the arc of a 1533.00 foot radius non-tangential circular curve to the left, having a chord which bears S01°03'06"W 18.43 feet; thence S00°42'26"W 127.00 feet; thence N89°17'34"W 331.46 feet to the Place of Beginning, being a part of the NW 1/4 of said Section 36, containing 14.12 acres of land, more or less, being subject to easements and restrictions of record, if any. (Units 4-10, 51-55, 154-156, 173-188, 249-252 and private open space.)

Commencing at the W 1/4 Corner of Section 36, T3S, R5E, City of Saline, Washtenaw County, Michigan; thence S89°17'34"E 927.78 feet along the E-W 1/4 line of said section and the centerline of Saline-Waterworks Road; thence along the west line of Colony Estates as recorded in Liber 21 of Plats, Pages 84-86, Washtenaw County Records the following 2 courses: N1°30'20"W 164.54 feet and N33°25'40"W 78.36 feet for a Place of Beginning; thence 215.08 feet along the arc of a non-tangential circular curve to the right, radius 1685.86 feet, chord N86°26'32"W 214.94 feet; thence N82°47'14"W 63.05 feet; thence 20.64 feet along the arc of a non-tangential circular curve to the right, radius 1467.00 feet, chord N4°07'24"E 20.64 feet; thence 131.33 feet along the arc of a reverse circular curve to the left, radius 1533.00 feet, chord N2°04'20"E 131.29 feet; thence 156.85 feet along the arc of a compound circular curve to the left, radius 783.00 feet, chord N6°07'15"W 156.59 feet; thence N79°50'00"E 40.78 feet; thence 410.65 feet along the arc of a circular curve to the left, radius 283.00 feet, chord N38°15'48"E 375.56 feet; thence 462.68 feet along the arc of a reverse circular curve to the right, radius 317.00 feet, chord N38°30'23"E 422.69 feet; thence N80°19'10"E 638.86 feet; thence 27.85 feet along the arc of a non-tangential circular curve to the right, radius 767.00 feet, chord S7°40'22"E 27.85 feet; thence 248.57 feet along the arc of a compound circular curve to the right, radius 1685.86 feet, chord S2°24'31"E 248.35 feet; thence 0.75 feet along the arc of a reverse circular curve to the left, radius 1751.86 feet, chord S1°49'41"W 0.75 feet; thence 222.89 feet along the arc of a non-tangential circular curve to the left, radius 1751.86 feet, chord S83°57'51"W 222.74 feet; thence S80°19'10"W

300.92 feet; thence 51.73 feet along the arc of a circular curve to the right, radius 75.00 feet, chord N79°55'18"W 50.71 feet; thence 293.87 feet along the arc of a reverse circular curve to the left, radius 65.00 feet, chord S9°40'50"E 100.29 feet; thence 51.73 feet along the arc of a reverse circular curve to the right, radius 75.00 feet, chord N60°33'38"E 50.71 feet; thence N80°19'10"E 300.92 feet; thence 210.92 feet along the arc of a circular curve to the right, radius 1685.86 feet, chord N83°54'13"E 210.78 feet; thence 109.90 feet along the arc of a non-tangential circular curve to the left, radius 1751.86 feet, chord S2°10'06"E 109.86 feet; thence along the north and west lines of said Colony Estates the following 8 courses: S84°07'30"W 136.53 feet, S43°55'40"W 28.98 feet, S80°41'40"W 185.94 feet, S79°54'00"W 166.26 feet, S76°15'40"W 284.80 feet, S11°59'30"W 294.70 feet, N86°31'45"W 55.00 feet and S0°05'50"E 170.00 feet to the Place of Beginning, being a part of the NW 1/4 of said Section 36 and containing 11.26 acres of land, more or less (Units 11-50).

Commencing at the W 1/4 Corner of Section 36, T3S, R5E, City of Saline, Washtenaw County, Michigan; thence N01°35'00"E 2442.03 feet along the West line of said Section 36; thence S89°28'10"E 150.00 feet; thence S01°35'00"W 129.39 feet; thence 315.13 feet along the arc of a 444.91 foot radius circular curve to the left, having a chord which bears S18°42'31"E 308.59 feet; thence S39°00'00"E 397.70 feet; thence 69.22 feet along the arc of a 583.00 foot radius circular curve to the left, having a chord which bears S42°24'05"E 69.19 feet for a Place of Beginning; thence continuing 231.73 feet along the arc of a 583.00 foot radius circular curve to the left, having a chord which bears S57°11'22"E 230.21 feet; thence 166.76 feet along the arc of a 342.00 foot radius non-tangential circular curve to the right, having a chord which bears S34°19'33"W 165.11 feet; thence 746.40 feet along the arc of a 709.00 foot radius reverse circular curve to the left, having a chord which bears S18°08'06"W 712.41 feet; thence S12°01'27"E 122.42 feet; thence non-tangentially S79°50'00"W 44.05 feet; thence 361.57 feet along the arc of a 217.00 foot radius circular compound curve to the right, having a chord which bears N52°25'58"W 321.17 feet; thence 881.94 feet along the arc of a 969.13 foot radius circular curve to the right, having a chord

which bears N21°22'16"E 851.82 feet; thence N47°26'30"E 113.20 feet to the Place of Beginning, being in the NW 1/4 of said Section 36, containing 6.46 acres of land, more or less, being subject to easements and restrictions of record, if any. (Units 56-58, 82-95 and 157-172.)

Commencing at the W 1/4 Corner of Section 36, T3S, R5E, City of Saline, Washtenaw County, Michigan; thence S89°17'34"E 200.00 feet along the E-W 1/4 line of said Section 36 and the centerline of Saline-Waterworks Road; thence N01°35'00"E 435.60 feet; thence N89°17'45"W 200.00 feet; thence N01°35'00"E 10.00 feet along the west line of said Section 36; thence N49°21'26"E 270.47 feet; thence N51°47'33"E 66.08 feet; thence N48°36'57"E 126.58 feet; thence S50°40'26"E 36.62 feet; thence S61°37'20"E 46.27 feet; thence N78°49'37"E 57.69 feet; thence N12°01'27"W 7.88 feet; thence N77°58'33"E 66.00 feet for a Place of Beginning; thence 676.92 feet along the arc of a circular curve to the right, radius 643.00 feet, chord bearing N18°08'06"E 646.09 feet; thence 201.45 feet along the arc of a 408.00 foot radius circular curve to the left, chord bearing N34°08'57"E 199.41 feet; thence 248.42 feet along the arc of a 583.00 foot radius non-tangential circular curve to the left, chord bearing S87°16'38"E 246.55 feet; thence N80°30'56"E 234.61 feet; thence 195.13 feet along the arc of a 394.33 foot radius circular curve to the left, chord bearing N66°20'22"E 193.14 feet; thence N52°09'49"E 82.54 feet; thence S37°50'11"E 32.86 feet; thence 323.83 feet along the arc of a 767.00 foot radius circular curve to the right, chord S25°44'29"E 321.43 feet; thence S80°19'10"W 637.14 feet; thence 559.01 feet along the arc of a circular curve to the left, radius 383.00 feet, chord bearing S38°30'23"W 510.70 feet; thence 314.88 feet along the arc of a circular curve to the right, radius 217.00 feet, chord bearing S38°15'48"W 287.98 feet; thence S79°50'00"W 42.92 feet; thence N12°01'27"W 124.56 feet to the Place of Beginning, being a part of the NW 1/4 of said Section 36, containing 9.45 acres of land, more or less, and being subject to easements of record, if any (Units 59-79 and 96-119).

Commencing at the W 1/4 corner of Section 36, T3S, R5E, City of Saline, Washtenaw County, Michigan; thence N01°35'00"E 2442.04 feet along the west line of said Section 36; thence S89°28'10"E 216.01 feet; thence S01°35'00"W 130.60 feet; thence 268.38 feet

along the arc of a 378.91 foot radius circular curve to the left, chord bearing S18°42'30"E 262.81 feet; thence S39°00'00"E 397.71 feet; thence 545.77 feet along the arc of a 517.00 foot radius circular curve to the left, chord bearing S69°14'32"E 520.78 feet; thence N80°30'56"E 234.60 feet; thence 162.47 feet along the arc of a 328.33 foot radius circular curve to the left, chord bearing N66°20'22"E 160.82 feet; thence N52°09'49"E 148.54 feet; thence S37°50'11"E 66.00 feet for a Place of Beginning; thence N52°09'49"E 104.99 feet; thence 25.02 feet along the arc of a 317.00 foot radius circular curve to the right, chord bearing N54°25'29"E 25.01 feet; thence S36°58'43"E 80.27 feet; thence S32°55'11"E 68.43 feet; thence S28°50'50"E 68.43 feet; thence S24°46'29"E 68.43 feet; thence S20°42'09"E 68.43 feet; thence S16°37'48"E 68.43 feet; thence S75°24'23"W 130.00 feet; thence 337.93 feet along the arc of a 833.00 foot radius circular curve to the left, chord bearing N26°12'54"W 335.61 feet; thence N37°50'11"W 32.86 feet to the Place of Beginning, being a part of the NW 1/4 of said Section 36, containing 1.18 acres of land, more or less, being subject to easements and restrictions of record, if any (Units 80, 81 and 120-123).

Commencing at the W 1/4 corner of Section 36, T3S, R5E, City of Saline, Washtenaw County, Michigan; thence N01°35'00"E 2508.04 feet along the west line of said Section 36 for a Place of Beginning; thence continuing N01°35'00"E 129.99 feet along the west line of said Section 36; thence S89°27'23"E 1562.49 feet along the North line of said Section 36; thence S03°15'18"E 623.54 feet; thence S89°27'23"E 561.30 feet; thence S17°02'05"E 125.51 feet along the centerline of Ann Arbor-Saline Road; thence S72°57'50"W 35.06 feet; thence 171.14 feet along the arc of a 242.00 foot radius circular curve to the right, having a chord which bears N86°46'35"W 167.60 feet; thence 409.90 feet along the arc of a 383.00 foot radius reverse curve to the left, having a chord which bears S82°49'24"W 390.61 feet; thence S52°09'49"W 104.99 feet; thence N37°50'11"W 138.97 feet; thence 336.02 feet along the arc of a 667.00 foot radius circular curve to the right, having a chord which bears N23°24'16"W 332.48 feet; thence 538.09 feet along the arc of a 383.00 foot radius reverse curve to the left, having a chord which bears N49°13'15"W 494.92 feet; thence N89°28'10"W 936.09 feet to the Place of

Beginning, being a part of the NW 1/4 of said Section 36, containing 10.84 acres of land, more or less, being subject to the rights of the public over the easterly 60.00 feet as occupied by Ann Arbor-Saline Road, subject to easements and restrictions of record, if any. (Units 124-125, 226-248 and private open space.)

Commencing at the W 1/4 corner of Section 36, T3S, R5E, City of Saline, Washtenaw County, Michigan; thence S89°17'34"E 200.00 feet along the E-W 1/4 line of said Section 36 and the centerline of Saline-Waterworks Road; thence N01°35'00"E 435.60 feet; thence N89°17'45"W 200.00 feet; thence N01°35'00"E 2006.45 feet along the West line of said Section 36; thence S89°28'10"E 216.01 feet for a Place of Beginning; thence continuing S89°28'10"E 721.29 feet; thence 445.37 feet along the arc of a 317.00 foot radius circular curve to the right, having a chord which bears S49°13'15"E 409.63 feet; thence 369.27 feet along the arc of a 733.00 foot radius reverse circular curve to the left, having a chord which bears S23°24'16"E 365.37 feet; thence S37°50'11"E 138.97 feet; thence S52°09'49"W 82.54 feet; thence 162.47 feet along the arc of a 328.33 foot radius circular curve to the right, having a chord which bears S66°20'22"W 160.82 feet; thence S80°30'56"W 75.86 feet; thence N09°29'04"W 101.85 feet; thence 144.17 feet along the arc of a 263.00 foot radius circular curve to the left, having a chord which bears N25°11'22"W 142.36 feet; thence 115.22 feet along the arc of a 301.55 foot radius reverse circular curve to the right, having a chord which bears N29°56'46"W 114.52 feet; thence N19°00'00"W 125.40 feet; thence 38.22 feet along the arc of a 50.00 foot radius circular curve to the right, having a chord which bears N02°54'03"E 37.30 feet; thence 303.59 feet along the arc of a 65.00 foot radius reverse circular curve to the left, having a chord which bears S71°00'00"W 93.83 feet; thence 38.22 feet along the arc of a 50.00 foot radius reverse circular curve to the right, having a chord which bears S40°54'03"E 37.30 feet; thence S19°00'00"E 92.40 feet; thence S71°00'00"W 53.93 feet; thence 55.57 feet along the arc of a 50.00 foot radius circular curve to the right, having a chord which bears N77°09'47"W 52.75 feet; thence 276.44 feet along the arc of a 65.00 foot radius reverse circular curve to the left, having a chord which bears S12°50'13"W 110.44 feet; thence N71°00'00"E 158.48 feet; thence 107.39 feet along the arc of a 367.55 foot radius circular curve to the left, having

a chord which bears S32°31'18"E 107.01 feet; thence 107.99 feet along the arc of a 197.00 foot radius circular curve to the right, having a chord which bears S25°11'18"E 106.64 feet; thence S09°29'04"E 101.84 feet; thence S80°30'56"W 92.74 feet; thence 545.77 feet along the arc of a 517.00 foot radius circular curve to the right, having a chord which bears N69°14'32"W 520.78 feet; thence N39°00'00"W 267.46 feet; thence N51°00'00"E 143.93 feet; thence 55.57 feet along the arc of a 50.00 foot radius circular curve to the right, having a chord which bears N82°50'13"E 52.75 feet; thence 276.44 feet along the arc of a 65.00 foot radius reverse circular curve to the left, having a chord which bears N07°09'47"W 110.44 feet; thence S51°00'00"W 247.00 feet; thence N39°00'00"W 64.24 feet; thence 268.38 feet along the arc of a 378.91 foot radius circular curve to the right, having a chord which bears N18°42'30"W 262.81 feet; thence N01°35'00"E 130.60 feet to the Place of Beginning, being a part of the NW 1/4 of said Section 36, containing 15.73 acres of land, more or less, and being subject to easements and restrictions of record, if any. (Units 126-153 and 189-225.)

Commencing at the W 1/4 corner of Section 36, T3S, R5E, City of Saline, Washtenaw County, Michigan; thence N01°35'00"E 2638.04 feet along the West line of said Section 36; thence S89°28'10"E 1563.33 feet along the North line of said Section 36; thence S03°29'00"E 621.21 feet; thence S89°28'10"E 558.19 feet; thence S17°02'10"E 194.33 feet along the center line of Ann Arbor-Saline Road for a Place of Beginning; thence along the northerly line of Woodland Drive the following 3 courses: S72°57'50"W 36.02 feet, 217.82 feet along the arc of a tangential circular curve to the right, radius 308.00 feet chord bearing N86°46'35"W 213.31 feet and 314.24 feet along the arc of a tangential circular curve to the left, radius 317.00 feet chord bearing S85°05'04"W 301.53 feet; thence S36°58'43"E 80.27 feet; thence S32°55'11"E 68.43 feet; thence S28°50'50"E 68.43 feet; thence S24°46'29"E 68.43 feet; thence S20°42'09"E 68.43 feet; thence S16°37'48"E 68.43 feet; thence S75°24'23"W 130.00 feet; thence along the easterly line of Colony Drive the following 3 courses: 115.74 feet along arc of a tangential circular curve to the right, radius 833.00 feet chord bearing S10°36'47"E 115.65 feet, 258.30 feet along the arc of a tangential circular

curve to the right, radius 1751.86 feet chord bearing S02°24'31"E 258.07 feet and 115.95 feet along the arc of a tangential circular curve to the left, radius 1685.86 feet chord bearing S00°09'18"E 115.92 feet; thence N78°15'10"E 200.00 feet; thence S06°56'15"E 89.14 feet; thence S89°17'45"E 40.02 feet; thence N12°40'10"W 74.60 feet; thence N77°19'50"E 260.60 feet; thence N12°40'10"W 360.00 feet; thence N77°19'50"E 175.00 feet; thence N12°40'10"W 135.36 feet along the center line of Ann Arbor-Saline Road; thence N17°02'10"W 328.89 feet continuing along the center line of Ann Arbor-Saline Road to the Place of Beginning; being a part of the N 1/2 of said Section 36, containing 9.85 acres or land, more or less, being subject to the rights of the public over the easterly 60.00 feet thereof as occupied by Ann Arbor-Saline Road, subject to easements and restrictions of record, if any (private open space).

Also including a Drain Easement for Detention Basin No. 3 as follows: Commencing at the W 1/4 Corner of Section 36, T3S, R5E, City of Saline, Washtenaw County, Michigan; thence S89°17'34"E 927.78 feet along the E-W 1/4 line and the centerline of Saline-Waterworks Road; thence along the west line of Colony Estates Subdivision as recorded in Liber 21 of Plats, Pages 84-86, Washtenaw County Records, the following 5 courses: N01°30'20"W 164.54 feet, N33°25'40"W 78.36 feet, N00°05'50"W 170.00 feet, S86°31'45"E 55.00 feet and N11°59'30"E 294.70 feet; thence N02°00'00"W 185.82 feet; thence N08°54'45"E 110.00 feet, thence N51°32'13"E 122.00 feet; thence N80°19'10"E 483.00 feet; thence N83°41'17"E 95.06 feet; thence N86°18'17"E 165.07 feet for a Place of Beginning; thence 121.95 feet along the arc of a non-tangential circular curve to the left, radius 1751.86 feet, chord N04°38'18"W 121.93 feet; thence 115.74 feet along the arc of a circular curve to the left, radius 833.00 feet, chord bearing N10°36'47"W 115.65 feet; thence nontangentially N75°24'23"E 197.21 feet; thence S08°24'54"E 246.83 feet; thence S78°15'10"W 200.00 feet to the Place of Beginning, being a part of the NW 1/4 of said Section 36, containing 1.07 acres of land more or less.

Also including an easement for public utilities as follows: Commencing at the W 1/4 corner of Section 36, T3S, R5E, City of Saline, Washtenaw County, Michigan; thence N01°35'00"E 2442.04 feet along the west line of said Section 36; thence S89°28'10"E

216.01 feet; thence S01°35'00"W 130.60 feet; thence 268.38 feet along the arc of a 378.91 foot radius circular curve to the left, chord bearing S18°42'30"E 262.81 feet; thence S39°00'00"E 397.71 feet; thence 545.77 feet along the arc of a 517.00 foot radius circular curve to the left, chord bearing S69°14'32"E 520.78 feet; thence N80°30'56"E 234.60 feet; thence 162.47 feet along the arc of a 328.33 foot radius circular curve to the left, chord bearing N66°20'22"E 160.82 feet; thence N52°09'49"E 253.53 feet; thence 48.63 feet along the arc of a circular curve to the right, radius 383.00 feet, chord bearing N55°48'03"E 48.59 feet for a Place of Beginning; thence N03°55'51"E 69.15 feet; thence N71°25'51"E 96.24 feet; thence S63°34'09"E 104.39 feet; thence 57.44 feet along the arc of a non-tangential circular curve to the left, radius 383.00 feet, chord bearing S84°54'40"W 57.38 feet; thence N63°34'09"W 43.05 feet; thence S71°25'51"W 63.76 feet; thence S03°55'51"W 30.47 feet; thence 35.33 feet along the arc of a non-tangential circular curve to the left, radius 383.00 feet, chord bearing S62°04'50"W 35.32 feet to the Place of Beginning, being a part of the NW 1/4 of said Section 36, containing 0.14 acres of land, more or less, being subject to easements and restrictions of record, if any.

WHEREAS, the Developer desires, by recording this Consolidated Master Deed, together with the By-Laws attached hereto as Exhibit "A" and together with Replat No. 7 of the Condominium Subdivision Plan attached hereto as Exhibit "B" (both of which are hereby incorporated by reference and made a part hereof), to establish the real property, together with the improvements located and to be located thereon and the appurtenances thereto, as a condominium project under the provisions of the Act:

NOW, THEREFORE, the Developer does, upon the recording hereof, establish Northview as a condominium project under the Act and does declare that Northview (hereinafter referred to as the "Condominium" or the "condominium project") shall, after such establishment, be held, conveyed, mortgaged, encumbered, leased, rented, occupied, improved, or in any other manner utilized subject to the provisions of the Act and to the covenants, conditions, restrictions, uses, limitations, and affirmative obligations set forth in this Consolidated Master Deed and Exhibits "A" and "B" hereto, all of which shall be deemed to run with the land and shall be a burden and a benefit to the Developer, its successors and assigns, and any persons acquiring or owning an interest in the said real property, their grantees,

successors, heirs, personal representatives, and assigns. In furtherance of the establishment of said condominium project, it is provided as follows:

FIRST: Certain terms are utilized not only in this Consolidated Master Deed and Exhibits "A" and "B" hereto, but are or may be used in various other instruments such as, by way of example and not in limitation, the Articles of Incorporation and Rules and Regulations of the Saline Northview Condominium Association, a Michigan non-profit corporation, and deeds, mortgages, liens, land contracts, easements, and other instruments affecting the establishment of or transfer of interests in Northview as a condominium. Wherever used in such documents or any other pertinent instruments, the terms set forth below shall be defined as follows:

- (1) The "Act" means the Michigan Condominium Act, being Act 59 of the Public Acts of 1978, as amended.
- (2) "Association" means Saline Northview Condominium Association, the non-profit corporation organized under Michigan law of which all co-owners shall be members, which corporation shall administer, operate, manage, and maintain the Condominium. Any action required of or permitted to the Association shall be exercisable by its Board of Directors unless specifically reserved to its members by the Condominium documents or the laws of the State of Michigan.
- (3) "Building envelope" means the portion of each unit within which the co-owner thereof may construct improvements such as a residence. No structures may be built outside of the building envelope within each unit as shown on Exhibit "B" attached hereto without the advance written approval of the Association and the City of Saline, if applicable.
- (4) "By-Laws" means Exhibit "A" hereto, being the By-Laws setting forth the substantive rights and obligations of the co-owners and required by Section 3(8) of the Act to be recorded as part of the Consolidated Master Deed. The By-Laws shall also constitute the corporate By-Laws of the Association as provided for under the Michigan Non-Profit Corporation Act.
- (5) "Common elements", where used without modification, shall mean both the general and limited common elements described in paragraph FOURTH hereof.
- (6) "Condominium documents" wherever used means and includes this Consolidated Master Deed and Exhibits "A" and "B" hereto, the Articles of Incorporation and the Rules and Regulations, if any, of the Association.
- (7) "Condominium premises" means and includes the land, all improvements and structures thereon, and all easements, rights and appurtenances belonging to Northview as described above.
- (8) "Condominium", "condominium project" or "project" means Northview established in conformity with the provisions of the Act.
- (9) "Condominium Subdivision Plan" means Exhibit "B" hereto.
- (10) "Construction and sales period" means, for the purposes of the Condominium documents and the rights reserved to the Developer thereunder, the period commencing with the recording of the initial Master Deed and continuing as long as the Developer owns any unit which it offers for sale.
- (11) "Co-owner" means a person, firm, corporation, partnership, association, trust, or other legal entity or any combination thereof who or which owns one or more units in the condominium project. The term "owner", wherever used, shall be synonymous with the term "co-owner". "Co-owner" shall also include a land contract vendee.
- (12) "Developer" means Peters Building Co., a Michigan corporation, which has made and executed this Master Deed, and its successors and assigns.
- (13) "First annual meeting" means the initial meeting at which nondeveloper co-owners

are permitted to vote for the election of all Directors and upon all other matters which properly may be brought before the meeting.

- (14) "Transitional control date" means the date on which a Board of Directors of the Association took office pursuant to an election in which the votes which may be cast by eligible co-owners unaffiliated with the Developer exceeded the votes which could be cast by the Developer.
- (15) "Unit" means a single condominium unit in Northview, as described in paragraph FIFTH hereof and in Exhibit "B" hereto, and shall have the same meaning as "condominium unit" as defined in the Act.
- (16) Whenever any reference herein is made to one gender, the same shall include a reference to any and all genders where the same would be appropriate; similarly, whenever a reference is made herein to the singular, a reference shall also be included to the plural where the same would be appropriate.

SECOND: The condominium project shall be known as Northview, Washtenaw County Condominium Subdivision Plan No. 93. The engineering and architectural plans for the project (including all dwellings and other improvements to be constructed therein) were or will be approved by, and are or will be on file with, the City of Saline, Washtenaw County, State of Michigan. The condominium project is established in accordance with the Act.

THIRD: The units contained in the Condominium, including the number, boundaries, dimensions, and area of each condominium unit therein, are set forth completely in the Condominium Subdivision Plan attached as Exhibit "B" hereto. Each unit has been created for residential purposes and each unit is capable of individual utilization on account of having its own access to a public street. Each co-owner in the condominium project shall have an exclusive right to his condominium unit and shall have undivided and inseparable rights to share with other co-owners the common elements of the condominium project as are designated by this Consolidated Master Deed.

FOURTH: The common elements of the project described in Exhibit "B" attached hereto and the respective

responsibilities for the maintenance, decoration, repair, or replacement thereof are as follows:

(1). The general common elements are:

(a) The land described in page one hereof (other than that portion thereof described in paragraph FIFTH below and in Exhibit "B" hereto as constituting the condominium units), including improvements not designated as limited common elements and not located within the boundaries of a condominium unit. Those structures and improvements that now or hereafter are located within the boundaries of a condominium unit shall be owned in their entirety by the co-owner of the unit in which they are located and shall not, unless otherwise expressly provided in the Condominium documents, constitute common elements;

(b) The electrical wiring network throughout the project up to, but not including, the electric meter for each residential dwelling that now or hereafter is constructed within the perimeter of a unit;

(c) The gas line network throughout the project up to, but not including, the gas meter for each residential dwelling that now or hereafter is constructed within the perimeter of a unit;

(d) The telephone and television wiring network throughout the project up to the point of connection with each residential dwelling that now or hereafter is constructed within the perimeter of a unit;

(e) The water distribution system, sanitary sewer system, and storm drainage system throughout the project;

(f) Such other elements of the project not herein designated as general or limited common elements which are not located within the perimeter of a unit and which are intended for common use or necessary to the existence, upkeep and safety of the project.

Some or all of the utility lines (including mains and service leads) and equipment described in paragraph FOURTH (1)(b), (c), (d), and (e) may be owned by the local municipal authority or by the company that is providing the pertinent utility service. Accordingly, such utility lines

and equipment shall be general common elements only to the extent of the co-owners' interest therein, and the Developer makes no warranty whatever with respect to the nature or extent of such interest, if any.

(2). Limited common elements, if any, shall be subject to the exclusive use and enjoyment of the co-owner of the unit or units to which such limited common elements are appurtenant. No limited common elements have been designated as such in this Consolidated Master Deed because there are no limited common elements in this project. If any limited common elements are included in the project at any time hereafter, they shall be shown on amendments to the Condominium Subdivision Plan.

(3). The respective responsibilities for the maintenance, decoration, repair, and replacement of the common elements are as follows:

(a) Association Responsibilities. The responsibility for performing the maintenance, repair and replacement of all walks and driveways in the project, regardless of whether located within or without a condominium unit, shall be borne by the Association; provided, however, that if a majority of all co-owners so agree in writing, the Association's liability with respect to the walks and driveways shall be limited to repair and replacement thereof, and the respective co-owners shall thereafter be responsible for maintenance of the walks and driveways, including snow removal therefrom. In the event a majority of the co-owners do so agree, an affidavit to that effect shall be made by an officer of the Association and recorded in the Office of the Washtenaw County Register of Deeds and a copy thereof delivered to each co-owner. In no event shall any such election be made at any time during which the Developer owns a majority of the units in the project. If such work is performed upon a unit by the Association, the individual co-owner thereof shall reimburse the Association for all costs thereof within fifteen (15) days of billing or the Association shall have the right to recover its expenses in the same manner as established for the collection of assessments in Article II of the By-Laws. The costs of maintenance, repair and replacement of storm drains between and in the rear of units in the project, as shown on Exhibit "B", and all general common elements in the project shall be borne by the Association, subject to any provision of the Condominium documents expressly to the contrary. The Association also shall have the maintenance

responsibilities set forth in paragraph NINTH hereof.

(b) Co-Owner Responsibilities. The co-owners individually shall be responsible for the maintenance, repair and replacement of decks and for all decoration, maintenance, repair, or replacement that (i) is expressly assigned to them by any provision of the Condominium documents, or (ii) is not expressly assigned to the Association by any provision of the Condominium documents; but none of the co-owners shall be responsible individually for decoration, maintenance, repair, or replacement of any general common elements except as specifically provided in Article VI, Section 14 of the By-Laws.

FIFTH:

(1). Each unit of the condominium project is described in this paragraph with reference to the Condominium Subdivision Plan of Northview as surveyed by Atwell-Hicks, Inc., and attached hereto as Exhibit "B". Each unit shall consist of the land contained within the unit boundaries as shown on Exhibit "B" hereto and delineated with heavy outlines, together with all appurtenances thereto.

(2). The percentage value assigned to all units shall be equal. The determination that percentages of value should be equal was made after reviewing the comparative characteristics of each unit in the project and concluding that there are no material differences among the units insofar as the allocation of percentages of value is concerned. The percentage of value assigned to each unit shall be determinative of each co-owner's respective share of the common elements of the condominium project, the proportionate share of each respective co-owner in the proceeds and the expenses of administration and the value of such co-owner's vote at meetings of the Association. The total value of the project is one hundred percent (100%).

SIXTH: Notwithstanding any other provision in this Consolidated Master Deed or the By-Laws or any other documents, the following provisions shall apply and may not be amended or deleted without the prior written consent of the holder of each first mortgage of a condominium unit of record:

(1) A first mortgagee, at its request, is entitled to written notification from the Association of any default by the co-owner of such condominium unit in the performance of such

co-owner's obligations under the Condominium documents which is not cured within sixty (60) days.

(2) Any first mortgagee who obtains title to a unit pursuant to the remedies provided in the mortgage or foreclosure of the mortgage or deed (or assignment) in lieu of foreclosure shall be exempt from any "right of first refusal" contained in the Condominium documents and shall be free to sell or lease such unit without regard to any such provision.

(3) Any first mortgagee who obtains title to a unit pursuant to the remedies provided in the mortgage or foreclosure of the mortgage or deed (or assignment) in lieu of foreclosure shall not be liable for such unit's unpaid dues or charges which accrue prior to the acquisition of title to such unit by the mortgagee (except for claims for a pro rata share of such assessments or charges resulting from a pro rata reallocation of such assessments or charges to all units, including the mortgaged condominium unit).

(4) Unless at least sixty-seven percent (67%) of the first mortgagees (based upon one (1) vote for each mortgage owned) and co-owners (other than the sponsor, developer or builder) of the individual condominium units have given their prior written approval, the Association shall not be entitled to:

- (a) by act or omission seek to abandon or terminate the condominium project;
- (b) change the pro rata interest or obligations of any condominium unit for the purpose of (i) levying assessments or charges or allocating distributions of hazard insurance proceeds or condemnation awards, or (ii) determining the pro rata share of ownership of each unit in the common elements;
- (c) partition or subdivide any condominium unit;
- (d) by act or omission seek to abandon, partition, subdivide, encumber, sell, or transfer the common elements. The granting of easements for public utilities or for

other public purposes consistent with the intended use of the common elements by the condominium project shall not be deemed a transfer within the meaning of this clause;

- (e) use hazard insurance proceeds for losses to any condominium property (whether to units or to common elements) for other than the repair, replacement or reconstruction of such improvements, except as provided by statute in case of substantial loss to the units and/or common elements of the condominium project.

(5) Each first mortgagee has the right to examine the books and records of the Association and the condominium project.

(6) No condominium unit owner, or any other party, shall have priority over any rights of first mortgagees of condominium units pursuant to their mortgages in the case of a distribution to condominium unit owners of insurance proceeds or condemnation awards for losses to or a taking of condominium units and/or common elements.

(7) Any agreement for professional management of the condominium regime or any other contract providing for services which exists between the Association and the Developer or affiliates of the Developer is voidable by the Board of Directors of the Association on thirty (30) days' written notice at any time without cause or payment of a termination fee.

SEVENTH: In the event the Condominium is partially or totally damaged or destroyed or partially taken by eminent domain, the repair, reconstruction or disposition of the property shall be as provided by the By-Laws attached hereto as Exhibit "A".

EIGHTH: There shall be easements to, through and over all of the common elements in the project for the continuing maintenance and repair of all utilities in the Condominium. In the event any improvements located on one unit encroach upon a common element, easements shall exist for the maintenance of such encroachment for so long as such encroachment exists and for maintenance, repair and

replacement thereof following damage or destruction. The Board of Directors of the Association may grant easements over or through or dedicate any portion of any general common element of the Condominium for utility, roadway or safety purposes.

NINTH: There shall be easements to and in favor of the Association, and its officers, directors, agents, and designees, in, on and over all units and common elements in the project for access to the units and the exterior of each of the residential dwellings that is constructed within the project to permit the maintenance, repair, replacement, and/or decoration thereof in accordance with the terms hereof. Except as otherwise expressly provided herein, and upon the failure of the co-owner to perform such work, the Association shall be responsible for performing the routine decoration and maintenance of the exteriors, including roofs, of all residential dwellings constructed in the project, all fences enclosing or partially enclosing courtyards and patio areas and any portion of a unit that consists primarily of grass and that is not enclosed by a fence or is otherwise inaccessible to lawn maintenance equipment; provided, however, that if a majority of all co-owners so agree in writing, the Association's liability with respect to maintenance responsibilities as set forth hereinabove may be discontinued. In the event a majority of the co-owners do so agree, an affidavit to that effect shall be made by an officer of the Association and recorded in the office of the Washtenaw County Register of Deeds, and a copy thereof delivered to each co-owner. In no event shall any such election be made at any time during which the Developer owns a majority of the units in the project. If such work is performed upon a unit by the Association, the individual co-owner thereof shall reimburse the Association for all costs thereof within fifteen (15) days of billing or the Association shall have the right to recover its expenses in the same manner as established for the collection of assessments in Article II of the By-Laws. There also shall exist easements to and in favor of the Association, and its officers, directors, agents, and designees, in, on and over all units and common elements of the project for access to and maintenance of those common elements of the project for which the Association may from time to time be responsible. The Association shall in no event be obligated to repair any dwelling or other improvement located within or appurtenant to a unit to the extent the repair is necessitated on account of any occurrence with respect to which a co-owner is required under the Condominium documents to maintain insurance coverage, nor shall the Association be obligated to make any capital expenditures of any type whatever with respect to such dwellings or improvements or to perform any maintenance or repair thereon other than routine maintenance

and repair of a type generally required on an ongoing basis throughout the project.

TENTH: The Developer further reserves the right at any time to grant easements for utilities over, under and across the condominium premises to appropriate governmental agencies or public utility companies and to transfer title to utilities to governmental agencies or to utility companies. Any such easement or transfer of title may be made by the Developer without the consent of any co-owner, mortgagee or other person and shall be evidenced by an appropriate amendment to this Consolidated Master Deed and to Exhibit "B" hereto, recorded in the Washtenaw County Records. All of the co-owners and mortgagees of units and other persons interested or to become interested in the project from time to time shall be deemed to have irrevocably and unanimously consented to such amendment or amendments of this Master Deed as may be required to effectuate the foregoing grant of easement or transfer of title.

ELEVENTH: The Association, acting through its lawfully constituted Board of Directors shall be empowered and obligated to grant such easements, licenses, rights-of-entry, and rights-of-way over, under and across the condominium premises for utility purposes, access purposes or other lawful purposes as may be necessary for the benefit of the Condominium; subject, however, to the approval of the Developer during the construction and sales period. No easement created under the Condominium documents may be modified nor may any of the obligations with respect thereto be varied without the consent of each person benefited thereby.

TWELFTH: The Developer, the Association and all public or private utilities shall have such easements over, under, across, and through the condominium premises, including all units and common elements, as may be necessary to fulfill any responsibilities of maintenance, repair, or replacement which they or any of them are required or permitted to perform under the Condominium documents or by law. These easements include, without limitation, the right of the Association to obtain access to the unit during reasonable hours.

THIRTEENTH: Except as provided in preceding paragraphs as set forth above, the condominium project shall not be terminated or any of the provisions of this Consolidated Master Deed or Exhibits attached hereto amended unless done in compliance with the following provisions:

(1) After the first annual meeting of members of the Association, the Association may (acting through a majority of its Board of Directors and without the consent of any co-owner or any other person) amend this Consolidated Master Deed and the plans attached as Exhibit "B" in order to correct survey or other errors made in such documents and to make such other amendments to such instruments and to the By-Laws attached hereto as Exhibit "A" as do not materially affect any rights of any co-owners in the project or impair the security of any mortgagee, including, but not limited to, amendments for the purpose of maintaining this Consolidated Master Deed in compliance with the Act and of facilitating conventional mortgage loan financing for existing or prospective co-owners and to enable the purchase of such mortgage loans by the Federal Home Loan Mortgage Corporation, the Federal National Mortgage Association, the Government National Mortgage Association, and/or any other agency of the Federal government or the State of Michigan.

(2) If there is a co-owner other than the Developer, then the condominium project shall be terminated only by the unanimous agreement of the Developer, unaffiliated co-owners of condominium units to which all of the votes in the Association appertain and the mortgagees of all of the mortgages covering the condominium units.

(3) Agreement of all of the co-owners and mortgagees to the termination of the Condominium shall be evidenced by their execution of the termination agreement or of ratifications thereof, and the termination shall become effective only when the agreement is so evidenced of record.

(4) Upon recordation of an instrument terminating a condominium project, the property constituting the condominium project shall be owned by the co-owners as tenants in common in proportion to their respective undivided interests in the common elements immediately before recordation. As long as the tenancy in common lasts, each co-owner or the heirs, successors or assigns thereof shall have an exclusive right of occupancy of that portion of the property which formerly constituted the condominium unit.

(5) Upon recordation of an instrument terminating a condominium project, any rights the

co-owners may have to the assets of the Association shall be in proportion to their respective undivided interests in the common elements immediately before recordation, except that common profits shall be distributed in accordance with the Condominium documents and the Act.

(6) The Condominium documents may be amended by the Developer, on behalf of itself, and on behalf of the Association, for a proper purpose without the consent of co-owners, mortgagees and other interested parties, including changes deemed necessary to comply with the Act and the modification of sizes of unsold condominium units, as long as the amendments do not materially alter or change the rights of the co-owners, mortgagees or other interested parties.

(7) The Condominium documents may be amended for a proper purpose, other than as set forth above, even if the amendment will materially alter or change the rights of the co-owners, mortgagees or other interested parties, with the prior written consent of sixty-seven percent (67%) of the first mortgagees (based upon one (1) vote for each mortgage owned) and co-owners (other than the Developer) of the individual condominium units. A co-owner's condominium unit dimensions or the nature or extent of any appurtenant limited common elements or the responsibility for maintenance, repair and replacement thereof may not be modified in any material way without his consent and that of his mortgagee.

(8) A person causing or requesting an amendment to the Condominium documents shall be responsible for costs and expenses of the amendment except for amendments based upon a vote of a prescribed majority of co-owners or based upon the Board of Director's decision, the costs of which are expenses of administration.

(9) A Master Deed amendment, dealing with the modification of units or other physical characteristics of the project shall comply with the standards prescribed in the Act for preparation of an original Condominium Subdivision Plan for the project.

(10) During the construction and sales period, paragraphs EIGHTH through this paragraph THIRTEENTH shall not be amended, nor shall the

provisions hereof be modified by any other amendment to this Consolidated Master Deed, without the written consent of the Developer.

FOURTEENTH: Any or all of the rights and powers granted or reserved to the Developer in the Condominium documents or by law, including the power to approve or disapprove any act, use or proposed action or any other matter or thing, may be assigned by it to any other entity or to the Association. Any such assignment or transfer shall be made by appropriate instrument in writing duly recorded in the office of the Washtenaw County Register of Deeds.

WITNESSES: PETERS BUILDING CO.,
Developer

Karl R. Frankena By: James Haeussler
Karl R. Frankena James Haeussler,
Nancy A. Pear Vice President

STATE OF MICHIGAN, COUNTY OF WASHTENAW

On this 18th day of September, 1996, before me appeared James Haeussler, to me personally known, who, being by me sworn, did say that he is the Vice President of Peters Building Co., a Michigan corporation, the corporation named in and which executed the within instrument, and that said instrument was signed and sealed on behalf of said corporation by authority of its Board of Directors, and said James Haeussler acknowledged said instrument to be the free act and deed of said corporation.

Karl R. Frankena
Karl R. Frankena, Notary Public
Washtenaw County, Michigan
My commission expires: 6/9/99

This document was prepared by
and when recorded return to:
Karl R. Frankena
Conlin, McKenney & Philbrick, P.C.
350 S. Main Street, Suite 400
Ann Arbor, Michigan 48104-2131

EXHIBIT A
NORTHVIEW
BY-LAWS

ARTICLE I

ASSOCIATION OF CO-OWNERS

Northview, a residential condominium project located in the City of Saline, Washtenaw County, Michigan, shall be administered by an association of co-owners which shall be a non-profit corporation, hereinafter called the "Association", organized under the applicable laws of the State of Michigan, and responsible for the management, maintenance, operation and administration of the common elements, easements and affairs of the condominium project in accordance with the Condominium documents and the laws of the State of Michigan. These By-Laws shall constitute both the By-Laws referred to in the Consolidated Master Deed and required by Section 3(8) of the Act and the By-Laws provided for under the Michigan Non-Profit Corporation Act. Each co-owner shall be entitled to membership, and no other person or entity shall be entitled to membership. The share of a co-owner in the funds and assets of the Association cannot be assigned, pledged or transferred in any manner except as an appurtenance to his unit. The Association shall keep current copies of the Consolidated Master Deed, all amendments to the Consolidated Master Deed and other Condominium documents for the condominium project available at reasonable hours to co-owners, prospective purchasers and prospective mortgagees of units in the condominium project. All co-owners in the condominium project and all persons using or entering upon or acquiring any interest in any unit therein or the common elements thereof shall be subject to the provisions and terms set forth in the aforesaid Condominium documents.

ARTICLE II

ASSESSMENTS

All expenses arising from the management, administration and operation of the Association in pursuance of its authorizations and responsibilities as set forth in the Condominium documents and the Act shall be levied by the Association against the units and the co-owners thereof in accordance with the following provisions:

Section 1. Assessments for Common Elements. All costs incurred by the Association in satisfaction of any liability arising within, caused by, or connected with the common elements or the administration of the condominium project shall constitute expenditures affecting the administration of the project, and all sums received as the proceeds of or pursuant to any policy of insurance securing the interest of the co-owners against liabilities or losses arising within, caused by, or connected with the common elements or the administration of the condominium project shall constitute receipts affecting the administration of the condominium project within the meaning of Section 54(4) of the Act.

Section 2. Determination of Assessments. Assessments shall be determined in accordance with the following provisions:

(a) Budget. The Board of Directors of the Association shall establish an annual budget in advance for each fiscal year, and such budget shall project all expenses for the forthcoming year which may be required for the proper operation, management and maintenance of the condominium project, including a reasonable allowance for contingencies and reserves. An adequate reserve fund for maintenance, repairs and replacement of those common elements that must be replaced on a periodic basis shall be established in the budget and must be funded by regular annual payments as set forth in Section 3 below rather than by special assessments. At a minimum, the reserve fund shall be equal to ten percent (10%) of the Association's current annual budget on a noncumulative basis. Since the minimum standard required by this subparagraph may prove to be inadequate for this particular project, the Board of Directors should carefully analyze the condominium project to determine if a greater amount should be set aside or if additional reserve funds should be established for other purposes from time to time and, in the event of such a determination, the Board of Directors shall be empowered to establish such greater or other reserves without co-owner approval. Upon adoption of an annual budget by the Board of Directors, copies of the budget shall be delivered to each co-owner and the assessment for said year shall be established based upon said budget, although the failure to deliver a copy of the budget to each co-owner shall not affect or in any way diminish the liability of any co-owner for any existing or future assessments. Should the Board of Directors at any time decide, in the sole discretion of the Board of Directors: (1) that the assessments

levied are or may prove to be insufficient to pay the costs of operation and management of the Condominium; (2) to provide replacements of existing common elements; (3) to provide additions to the common elements not exceeding \$10,000.00 annually for the entire condominium project (adjusted for increases in the Consumers Price Index used by the United States Department of Labor, Bureau of Vital Statistics, Metropolitan Detroit area, since the date of recording of the initial Master Deed); or (4) that an emergency exists, then the Board of Directors shall have the authority to increase the general assessment or to levy such additional assessment or assessments as it shall deem to be necessary. The Board of Directors also shall have the authority, without co-owner consent, to levy assessments pursuant to the provisions of Article V, Section 3 hereof. The discretionary authority of the Board of Directors to levy assessments pursuant to this subparagraph shall rest solely with the Board of Directors for the benefit of the Association and the members thereof, and shall not be enforceable by any creditors of the Association or of the members thereof.

(b) Special Assessments. Special assessments, in addition to those required in subparagraph (a) above, may be made by the Board of Directors from time to time and approved by the co-owners as hereinafter provided to meet other requirements of the Association, including, but not limited to: (1) assessments for additions to the common elements of a cost exceeding \$10,000.00 per year for the entire condominium project (adjusted for increases in the Consumers Price Index used by the United States Department of Labor, Bureau of Vital Statistics, Metropolitan Detroit area, since the date of recording of the initial Master Deed); (2) assessments to purchase a unit upon foreclosure of the lien for assessments described in Section 5 hereof; or (3) assessments for any other appropriate purpose not elsewhere herein described. Special assessments referred to in this subparagraph (b) (but not including those assessments referred to in subparagraph (a) above, which shall be levied in the sole discretion of the Board of Directors) shall not be levied without the prior approval of more than sixty percent (60%) of all co-owners. The authority to levy assessments pursuant to this subparagraph is solely for the benefit of the Association and the members thereof, and shall not be enforceable by any creditors of the Association or of the members thereof.

Section 3. Apportionment of Assessments and Penalty for Default. Unless otherwise provided herein or in the Consolidated Master Deed, all assessments levied against the co-owners to cover expenses of administration shall be apportioned among and paid by the co-owners in accordance with the percentage of value allocated to each unit in paragraph FIFTH of the Consolidated Master Deed, without increase or decrease for the existence of any rights to use of limited common elements appurtenant to a unit. Any other unusual common expenses benefiting less than all of the units, or any expenses incurred as a result of the conduct of less than all those entitled to occupy the Condominium project, or their tenants or invitees, shall be specifically assessed against the unit or units involved, in accordance with such reasonable rules and regulations as shall be adopted by the Board of Directors of the Association. Annual assessments as determined in accordance with Article II, Section 2(a) above shall be payable by co-owners in equal periodic installments as determined by the Board of Directors, commencing with acceptance of a deed to or a land contract vendee's interest in a unit, or with the acquisition of fee simple title to a unit by any other means. The payment of an assessment shall be in default if such assessment, or any part thereof, is not paid to the Association in full on or before the due date for such payment.

Each installment in default for ten (10) or more days shall bear interest from the initial due date thereof at the rate of seven percent (7%) per annum, plus such additional interest rate surcharge as the Board of Directors shall approve, until each installment is paid in full. Provided, however, that the interest rate and interest rate surcharge combined applying to delinquent amounts shall not exceed the limit set by usury laws in the State of Michigan. The Association may, pursuant to Article XIX, Section 4 hereof, levy fines for late payment of assessments in addition to such interest. Each co-owner (whether one (1) or more persons) shall be, and remain, personally liable for the payment of all assessments pertinent to his unit which may be levied while such co-owner is the owner thereof. Payments on account of installments of assessments in default shall be applied as follows: First, to cost of collection and enforcement of payment, including actual attorney's fees (not limited to statutory fees); second, to any interest charges and fines for late payment on such installments; third, to installments in default in order of their due dates.

Section 4. Waiver of Use or Abandonment of Unit. No co-owner may exempt himself from liability for his contribution toward the expenses of administration by waiver

of the use or enjoyment of any of the common elements or by the abandonment of his unit.

Section 5. Enforcement.

(a) Remedies. In addition to any other remedies available to the Association, the Association may enforce collection of delinquent assessments by a suit at law for a money judgment or by foreclosure of the statutory lien that secures payment of assessments. In the event of default by any co-owner in the payment of any installment of the annual assessment levied against his unit, the Association shall have the right to declare all unpaid installments of the annual assessment for the pertinent fiscal year immediately due and payable. The Association also may discontinue the furnishing of any utilities or other services to a co-owner in default upon seven (7) days' written notice to such co-owner of its intention to do so. A co-owner in default shall not be entitled to utilize any of the general common elements of the project and shall not be entitled to vote at any meeting of the Association so long as such default continues; provided, however, this provision shall not operate to deprive any co-owner of ingress or egress to and from his unit. In a judicial foreclosure action, a receiver may be appointed to collect a reasonable rental for the unit from the co-owner thereof or any persons claiming under him and, if the unit is not occupied, to lease the unit and collect and apply the rental therefrom to any delinquency owed to the Association. All of these remedies shall be cumulative and not alternative and shall not preclude the Association from exercising such other remedies as may be available at law or in equity.

(b) Foreclosure Proceedings. Each co-owner, and every other person who from time to time has any interest in the project, shall be deemed to have granted to the Association the unqualified right to elect to foreclose the lien securing payment of assessments either by judicial action or by advertisement. The provisions of Michigan law pertaining to foreclosure of mortgages by judicial action and by advertisement, as the same may be amended from time to time, are incorporated herein by reference for the purposes of establishing the alternative procedures to be followed in lien foreclosure actions and the rights and obligations of the parties to such actions. Further, each co-owner and every other person who from time to time has any interest in the project shall be deemed to have

authorized and empowered the Association to sell or to cause to be sold the unit with respect to which the assessment(s) is or are delinquent and to receive, hold and distribute the proceeds of such sale in accordance with the priorities established by applicable law. Each co-owner of a unit in the project acknowledges that, at the time of acquiring title to such unit, he was notified of the provisions of this subparagraph and that he voluntarily, intelligently and knowingly waived notice of any proceedings brought by the Association to foreclose by advertisement the lien for nonpayment of assessments and a hearing on the same prior to the sale of the subject unit.

(c) Notice of Action. Notwithstanding the foregoing, neither a judicial foreclosure action nor a suit at law for a money judgment shall be commenced, nor shall any notice of foreclosure by advertisement be published, until the expiration of ten (10) days after mailing, by first class mail, postage prepaid, addressed to the delinquent co-owner(s) at his or their last known address, of a written notice that one or more installments of the annual assessment levied against the pertinent unit is or are delinquent and that the Association may invoke any of its remedies hereunder if the default is not cured within ten (10) days after the date of mailing. Such written notice shall be accompanied by a written affidavit of an authorized representative of the Association that sets forth: (1) the affiant's capacity to make the affidavit; (2) the statutory and other authority for the lien; (3) the amount outstanding (exclusive of interest, costs, attorney's fees, and future assessments); (4) the legal description of the subject unit(s); and (5) the name(s) of the co-owner(s) of record. Such affidavit shall be recorded in the office of the Register of Deeds in the county in which the project is located prior to commencement of any foreclosure proceeding, but it need not have been recorded as of the date of mailing as aforesaid. If the delinquency is not cured within the ten (10) day period, the Association may take such remedial action as may be available to it hereunder or under Michigan law. In the event the Association elects to foreclose the lien by advertisement, the Association shall so notify the delinquent co-owner and shall inform him that he may request a judicial hearing by bringing suit against the Association.

(d) Expenses of Collection. The expenses incurred in collecting unpaid assessments, including interest, costs, actual attorney's fees (not limited to statutory fees) and advances for taxes or other liens paid by the Association to protect its lien, shall be chargeable to the co-owner in default and shall be secured by the lien on his unit.

Section 6. Liability of Mortgagee. Notwithstanding any other provision of the Condominium documents, the holder of any first mortgage covering any unit in the project which acquires title to the unit pursuant to the remedies provided in the mortgage or by deed (or assignment) in lieu of foreclosure, or any purchaser at a foreclosure sale, shall take the property free of any claims for unpaid assessments or charges against the mortgaged unit which accrue prior to the time such holder acquires title to the unit (except for claims for a pro rata share of such assessments or charges resulting from a pro rata reallocation of such assessments or charges to all units, including the mortgaged unit).

Section 7. Developer's Responsibility for Assessments. The Developer of the Condominium, although a member of the Association, shall not be responsible at any time for payment of the monthly Association assessments. The Developer, however, shall at all times pay all expenses of maintaining the units that it owns, including the dwellings and other improvements located thereon, together with a proportionate share of all current expenses of administration actually incurred by the Association from time to time except expenses related to maintenance and use of the units in the project and of the dwellings and other improvements constructed within or appurtenant to the units that are not owned by Developer. For purposes of the foregoing sentence, the Developer's proportionate share of such expenses shall be based upon the ratio of all units owned by the Developer at the time the expense is incurred to the total number of units then in the project. In no event shall Developer be responsible for payment of any assessments for deferred maintenance, reserves for replacement, for capital improvements, or other special assessments, except with respect to units owned by it on which a completed residential dwelling is located. Further, the Developer shall in no event be liable for any assessment levied in whole or in part to purchase any unit from the Developer or to finance any litigation or other claim against the Developer, any cost of investigating and preparing such litigation or claim, or similar related costs. A "completed residential dwelling" shall mean a dwelling with respect to which a certificate of occupancy has been issued by the City of Saline.

Section 8. Property Taxes and Special Assessments. All property taxes and special assessments levied by any public taxing authority shall be assessed in accordance with Section 131 of the Act.

Section 9. Personal Property Tax Assessment of Association Property. The Association shall be assessed as the person or entity in possession of any tangible personal property of the Condominium owned or possessed in common by the co-owners, and personal property taxes based thereon shall be treated as expenses of administration.

Section 10. Mechanic's Lien. A mechanic's lien otherwise arising under Act No. 497 of the Michigan Public Acts of 1980, as amended, shall be subject to Section 132 of the Act.

Section 11. Statement as to Unpaid Assessments. The purchaser of any unit may request a statement of the Association as to the amount of any unpaid Association assessments thereon, whether regular or special. Upon written request to the Association, accompanied by a copy of the executed purchase agreement pursuant to which the purchaser holds the right to acquire a unit, the Association shall provide a written statement of such unpaid assessments as may exist or a statement that none exist, which statement shall be binding upon the Association for the period stated therein. Upon the payment of that sum within the period stated, the Association's lien for assessments as to such unit shall be deemed satisfied; provided, however, that the failure of a purchaser to request such statement at least five (5) days prior to the closing of the purchase of such unit shall render any unpaid assessments and the lien securing the same fully enforceable against such purchaser and the unit itself to the extent provided by the Act. Under the Act, unpaid assessments constitute a lien upon the unit and the proceeds of the sale thereof prior to all claims except real property taxes and first mortgages of record.

ARTICLE III

ARBITRATION

Section 1. Scope and Election. Disputes, claims or grievances arising out of or relating to the interpretation or the application of the Condominium documents, or any disputes, claims or grievances arising among or between the co-owners and the Association, upon the election and written consent of the parties to any such disputes, claims or grievances (which consent shall include an agreement of the parties that the judgment of any circuit court of the State of Michigan may be rendered upon any award pursuant to such

arbitration) and upon written notice to the Association, shall be submitted to arbitration, and the parties thereto shall accept the arbitrator's decision as final and binding, provided that no question affecting the claim of title of any person to any fee or life estate in real estate is involved. The Commercial Arbitration Rules of the American Arbitration Association as amended and in effect from time to time hereafter shall be applicable to any such arbitration.

Section 2. Judicial Relief. In the absence of the election and written consent of the parties pursuant to Section 1 above, no co-owner or the Association shall be precluded from petitioning the courts to resolve any such disputes, claims or grievances.

Section 3. Election of Remedies. Such election and written consent by co-owners or the Association to submit any such dispute, claim or grievance to arbitration shall preclude such parties from litigating such dispute, claim or grievance in the courts.

ARTICLE IV

INSURANCE

Section 1. Extent of Coverage. The Association shall, to the extent appropriate given the nature of the general common elements of the project, carry "all risk" property coverage and liability insurance, fidelity coverage, and workmen's compensation insurance, if applicable, pertinent to the ownership, use and maintenance of the general common elements of the condominium project, and such insurance shall be carried and administered in accordance with the following provisions:

(a) Responsibilities of Association. All such insurance shall be purchased by the Association for the benefit of the Association and the co-owners and their mortgagees, as their interests may appear, and provision shall be made for the issuance of certificates of mortgagee endorsements to the mortgagees of co-owners.

(b) Insurance of Common Elements. All general common elements of the condominium project shall be insured against fire and other perils covered by a standard extended coverage endorsement, if appropriate, in an amount equal to the maximum insurable replacement value, excluding foundation and excavation costs, as determined annually by the Board of Directors of the Association.

(c) Premium Expenses. All premiums for insurance purchased by the Association pursuant to these By-Laws shall be expenses of administration.

(d) Proceeds of Insurance Policies. Proceeds of all insurance policies owned by the Association shall be received by the Association, held in a separate account and distributed to the Association and the co-owners and their mortgagees, as their interests may appear; provided, however, whenever repair or reconstruction of the Condominium shall be required as provided in Article V of these By-Laws, the proceeds of any insurance received by the Association as a result of any loss requiring repair or reconstruction shall be applied to such repair or reconstruction and in no event shall hazard insurance proceeds be used for any purpose other than for repair, replacement or reconstruction of the project unless sixty-seven percent (67%) of all of the institutional holders of first mortgages on units in the project have given their prior written approval.

Section 2. Authority of Association to Settle Insurance Claims. Each co-owner, by ownership of a unit in the condominium project, shall be deemed to appoint the Association as his true and lawful attorney-in-fact to act in connection with all matters concerning the maintenance of "all risk" property coverage, vandalism and malicious mischief, liability insurance, fidelity coverage and workmen's compensation insurance, if applicable, pertinent to the condominium project and the common elements appurtenant thereto, and such insurer as may, from time to time, provide such insurance to the condominium project. Without limitation on the generality of the foregoing, the Association as said attorney shall have full power and authority to purchase and maintain such insurance, to collect and remit premiums therefor, to collect proceeds and to distribute the same to the Association, the co-owners and their respective mortgagees, as their interests may appear (subject always to the Condominium documents), to execute releases of liability, and to execute all documents and to do all things on behalf of such co-owner and the Condominium as shall be necessary or convenient to the accomplishment of the foregoing.

Section 3. Responsibility of Co-Owners. Each co-owner shall be obligated and responsible for obtaining "all risk" property coverage and vandalism and malicious mischief insurance with respect to his residential dwelling and all other improvements constructed or to be constructed

within the perimeter of his condominium unit, and for his personal property located therein or thereon or elsewhere on the condominium project. All such insurance shall be carried by each co-owner in an amount equal to the maximum insurable replacement value, excluding foundation and excavation costs. In the event of the failure of a co-owner to obtain such insurance, the Association may obtain such insurance on behalf of such co-owner and the premiums therefor shall constitute a lien against the co-owner's unit which may be collected from the co-owner in the same manner that Association assessments may be collected in accordance with Article II hereof. Each co-owner also shall be obligated to obtain insurance coverage for his personal liability for occurrences within the perimeter of his unit or the improvements located thereon, and also for alternative living expenses in the event of fire. The Association shall under no circumstances have any obligation to obtain any of the insurance coverage described in this Section 3 or any liability to any person for failure to do so.

Section 4. Waiver of Right of Subrogation. The Association and all co-owners shall use their best efforts to cause all property and liability insurance carried by the Association or any co-owner to contain appropriate provisions whereby the insurer waives its right of subrogation as to any claims against any co-owner or the Association.

ARTICLE V

RECONSTRUCTION OR REPAIR

Section 1. Responsibility for Reconstruction or Repair. If any part of the condominium premises shall be damaged, the determination of whether or not it shall be reconstructed or repaired, and the responsibility therefor, shall be as follows:

(a) General Common Elements. If the damaged property is a general common element, the damaged property shall be rebuilt or repaired by the Association unless all of the co-owners and all of the institutional holders of mortgages on any unit in the project unanimously agree to the contrary.

(b) Unit or Improvements Thereon. If the damaged property is a unit or any improvements thereon, the co-owner of such unit alone shall determine whether to rebuild or repair the damaged property, subject to the rights of any mortgagee or other person or entity having an interest in such property, and such co-owner shall be responsible for

any reconstruction or repair that he elects to make. The co-owner shall in any event remove all debris and restore his unit and the improvements thereon to a clean and sightly condition satisfactory to the Association as soon as reasonably possible following the occurrence of the damage.

Section 2. Repair in Accordance with Consolidated Master Deed. Any such reconstruction or repair shall be substantially in accordance with the Consolidated Master Deed unless the co-owners shall unanimously decide otherwise.

Section 3. Association Responsibility for Repair. Immediately after the occurrence of a casualty causing damage to property for which the Association has the responsibility of maintenance, repair and reconstruction, the Association shall obtain reliable and detailed estimates of the cost to place the damaged property in a condition as good as that existing before the damage. If the proceeds of insurance are not sufficient to defray the estimated cost of reconstruction or repair required to be performed by the Association, or if at any time during such reconstruction or repair, or upon completion of such reconstruction or repair, the funds for the payment of the cost thereof are insufficient, assessment shall be made against all co-owners for the costs of reconstruction or repair of the damaged property in sufficient amounts to provide funds to pay the estimated or actual cost of repair.

Section 4. Timely Reconstruction and Repair. If damage to the general common elements adversely affects the appearance of the project, the Association shall proceed with replacement of the damaged property without delay.

Section 5. Eminent Domain. The following provisions shall control upon any taking by eminent domain:

(a) Taking of Unit or Improvements Thereon. In the event of any taking of all or any portion of a unit or any improvements thereon by eminent domain, the award for such taking shall be paid to the co-owner of such unit and the mortgagee thereof, as their interests may appear, notwithstanding any provision of the Act to the contrary. If a co-owner's entire unit is taken by eminent domain, such co-owner and his mortgagee shall, after acceptance of the condemnation award therefor, be divested of all interest in the condominium project.

(b) Taking of General Common Elements. If there is any taking of any portion of the general common elements, the condemnation proceeds relative to such taking shall be paid to the co-owners and their mortgagees in proportion to their respective interest in the common elements, and the affirmative vote of at least sixty-seven percent (67%) of the co-owners in number and in value shall determine whether to rebuild, repair or replace the portion so taken or to take such other action as they deem appropriate.

(c) Continuation of Condominium After Taking. In the event the condominium project continues after taking by eminent domain, then the remaining portion of the condominium project shall be re-surveyed and the Consolidated Master Deed amended accordingly and, if any unit shall have been taken, then paragraph FIFTH of the Consolidated Master Deed shall also be amended to reflect such taking and to proportionately readjust the percentages of value of the remaining units based upon the continuing value of the Condominium of one hundred percent (100%). Such amendment may be effected by an officer of the Association duly authorized by the Board of Directors without the necessity of execution of specific approval thereof by any co-owner.

(d) Notification of Mortgagees. In the event any unit in the Condominium, or any portion thereof, or the common elements or any portion thereof, is made the subject matter of any condemnation or eminent domain proceeding or is otherwise sought to be acquired by a condemning authority, the Association shall so notify each institutional holder of a first mortgage lien on any units in the Condominium.

(e) Applicability of the Act. To the extent not inconsistent with the foregoing provisions, Section 133 of the Act shall control upon any taking by eminent domain.

Section 6. Notification of FHLMC. In the event any mortgage in the Condominium is held by the Federal Home Loan Mortgage Corporation ("FHLMC"), then, upon request therefor by FHLMC, the Association shall give it written notice at such address as it may from time to time direct of any loss to or taking of the common elements of the Condominium if the loss or taking exceeds \$10,000 in amount or damage to a condominium unit covered by a

mortgage purchased in whole or in part by FHLMC if such damage exceeds \$1,000.

Section 7. Priority of Mortgagee Interests. Nothing contained in the Condominium documents shall be construed to give a co-owner or any other party priority over any rights of first mortgagees of units pursuant to their mortgages in the case of a distribution to co-owners of insurance proceeds or condemnation awards for losses to or a taking of units and/or common elements.

ARTICLE VI

RESTRICTIONS

All of the units in the Condominium shall be held, used and enjoyed subject to the following limitations and restrictions:

Section 1. Residential Use. No unit in the Condominium shall be used for other than single-family residential purposes as defined by the City of Saline Zoning Ordinance, and the common elements shall be used only for purposes consistent with single-family residential use.

Use of units shall also be restricted in the following manner:

(a) Building Size and Height: No building or structure shall exceed two stories in height and all buildings or structures shall be constructed within the perimeter of a unit. All buildings and structures shall be in conformity with the following minimum size standards as to living area measured by the external walls:

	<u>Unit Numbers 1-29, 154-156 and 215-239</u>	<u>Unit Numbers 30-79, 147-153, 189-214 and 240-248</u>
One Story/ Ranch	1,500 sq. feet	1,200 sq. feet
Story and One- Half	1,760 sq. feet (1st floor 1,260 sq. feet, 2nd floor 500 sq. feet)	1,340 sq. feet (1st floor 940 sq. feet, 2nd floor 400 sq. feet)
Two Story	1,800 sq. feet (900 sq. feet per floor)	1,500 sq. feet (750 sq. feet per floor)

Unit Numbers 80-146,
157-188 and 249-252

One 1,080 sq. feet
Story/
Ranch

Story 1,200 sq. feet (800 sq.
and feet first floor, 400 sq.
One- feet second floor)
Half

Two 1,300 sq. feet (650
Story sq. feet per floor)

Garages, porches and breezeways shall not be included in computing minimum size requirements. No part of a single story or ranch structure that is below ground level shall be included in computing minimum size requirements. No part of any other structure that is more than one-half below ground level shall be included in computing minimum size requirements.

(b) Garages: All single family dwellings shall have two-car attached garages, and with written approval from the Developer, or the Association as hereinafter provided in Section 3, may have three-car attached garages. Carports and detached garages shall not be erected, placed or permitted to remain on any unit.

(c) Temporary Structures: No old or used structure, of any kind, shall be placed upon any unit. No temporary structure of any character such as a tent, camper, trailer, shack, barn, and/or other out-building of any design whatsoever shall be erected or placed upon any unit prior to construction of the main residence, nor shall any such structure be occupied as living quarters at any time. This provision shall not prevent the use of temporary structures incidental to and during construction of the main residence provided that such temporary structures shall be removed from the premises immediately upon completion of the main residence.

(d) Accessory Buildings: No accessory building or other out-building shall be permitted on any unit unless it is approved by the Developer, or the Association, as hereinafter provided in Section 3. The Developer, or the Association, in the exercise of

its discretion, may permit the erection of structures such as swimming pool accessory buildings, greenhouses or lawn/garden storage sheds. Notwithstanding the Developer's, or the Association's approval, such structures shall be architecturally compatible with the main residence, be constructed of similar materials on a concrete slab with a rat wall, and shall not exceed 200 square feet in size.

(e) Swimming Pools: All swimming pools shall be below ground, except children's play pools, hot tubs and jacuzzi tubs, although above ground pools may be installed with the prior written consent from the Board of Directors and subject to such restrictions as it may place upon their use and location.

(f) Antenna. No radio, television or other antenna or aerial shall be permitted on an unit other than the type commonly used for residential purposes. Any antenna or aerial shall be installed on the main residence and not on a separate pole or tower. Dish or disc type antenna shall be limited to a size of not more than eighteen inches in diameter. No antenna, aerial, dish or disc shall extend beyond eight feet in height above the roof line on any dwelling.

(g) Fences: No co-owner shall construct, or cause to be constructed, any fence of any nature upon a unit or the common elements without the prior written approval of the Developer, or the Association, as set forth below in Section 3. The lineal footage of ornamental or decorative fences shall not exceed 40% of the unit's perimeter, shall not be located within the front set back, and shall not exceed five feet in height, except around swimming pools. Fences shall be used primarily for enclosure purposes. Perimeter fences around swimming pools shall be required to be constructed in accordance with all applicable building codes. Fences erected shall receive advance written approval of the Association as to size, location and fencing materials. Co-owners whose units adjoin general common elements or noncondominium lands will be allowed, with the advance written approval of the Association as to location, style, and material to construct a decorative or ornamental fence along the exterior boundaries of their units that are adjacent to the general common element or noncondominium lands. All fencing and or

COPY

screening shall be made of materials which are architecturally compatible with the main residence and designed in such a manner as to be aesthetically harmonious to the Condominium as a whole, specifically excluding cyclone fencing, snow fencing and plywood.

Section 2. Leasing and Rental.

(a) Right to Lease. A co-owner may lease his unit and the improvements thereon for the same purposes set forth in Section 1 of this Article VI provided that a written disclosure of such lease transaction is submitted to the Board of Directors of the Association in the manner specified in subsection (b) below. With the exception of a lender in possession of a unit following a default in a first mortgage, foreclosure, or deed or other arrangement in lieu of foreclosure, no co-owner shall lease less than an entire unit and the improvements thereon, and no tenant shall be permitted to occupy except under a lease the initial term of which is at least six (6) months unless specifically approved in writing by the Association. The terms of all leases, occupancy agreements and occupancy arrangements shall incorporate, or be deemed to incorporate, all of the provisions of the Condominium documents. The Developer may lease any number of units and the improvements thereon in its discretion.

(b) Leasing Procedures. The leasing of units and improvements thereon shall conform to the following provisions:

- (1) A co-owner, including the Developer, desiring to rent or lease a unit and the improvements thereon shall disclose that fact in writing to the Association at least ten (10) days before presenting a lease form to a potential lessee and, at the same time, shall supply the Association with a copy of the exact lease form for its review for its compliance with the Condominium documents.
- (2) Tenants and non-owner occupants shall comply with all of the conditions of the Condominium documents, and all leases and rental agreements shall so state.

(3) If the Association determines that the tenant or non-owner occupant has failed to comply with the conditions of the Condominium documents, the Association shall take the following action:

i. The Association shall notify the co-owner by certified mail advising of the alleged violation by the tenant.

ii. The co-owner shall have fifteen (15) days after receipt of such notice to investigate and correct the alleged breach by the tenant or advise the Association that a violation has not occurred.

iii. If, after fifteen (15) days, the Association believes that the alleged breach is not cured or may be repeated, it may institute on its behalf or derivatively by the co-owners on behalf of the Association, if it is under the control of the Developer, an action for eviction against the tenant or non-owner occupant and simultaneously for money damages in the same action against the co-owner and tenant or non-owner occupant for breach of the conditions of the Condominium documents. The relief provided for in this subparagraph may be by summary proceeding. The Association may hold both the tenant and the co-owner liable for any damages to the common elements caused by the co-owner or tenant in connection with the unit or the condominium project.

(4) When a co-owner is in arrears to the Association for assessments, the Association may give written notice of the arrearage to a tenant occupying a co-owner's unit under a lease or rental agreement and the tenant, after receiving the

notice, shall deduct from rental payments due the co-owner the arrearage and future assessments as they fall due and pay them to the Association. The deductions shall not constitute a breach of the rental agreement or lease by the tenant.

Section 3. Architectural Control. No dwelling, structure or other improvement shall be constructed within a condominium unit or elsewhere within the condominium project, nor shall any exterior modification be made to any existing dwelling, structure or improvement, unless plans and specifications therefor containing such detail as the Developer may reasonably request have first been approved by the Developer. Construction of any dwelling or other improvements must also receive any necessary approvals from the local public authority. The Developer shall have the right to refuse to approve any such plans or specifications or grading or landscaping plans which are not suitable or desirable in its opinion for aesthetic or other reasons; and in passing upon such plans and specifications it shall have the right to take into consideration the suitability of the proposed structure, improvement or modification, proposed exterior materials and exterior colors which shall blend in with existing residences and the natural surroundings, the site upon which it is proposed to be constructed and the degree of harmony thereof with the Condominium as a whole. The purpose of this Section is to assure the continued maintenance of the Condominium as a beautiful and harmonious residential development, and shall be binding upon both the Association and upon all co-owners. The Developer's rights under this Article VI, Section 3 may, in the Developer's discretion, be assigned to the Association or other successor to the Developer. The Developer may construct any improvements upon the condominium premises that it may, in its sole discretion, elect to make without the necessity of prior consent from the Association or any other person or entity, subject only to the express limitations contained in the Condominium documents.

Section 4. Changes in Common Elements. Except as provided in Article VI, Section 3 above with respect to the Developer, no co-owner shall make changes in any of the common elements without the express written approval of the Board of Directors of the Association.

Section 5. Activities. No immoral, improper, unlawful or offensive activity shall be carried on in any unit or upon the common elements, nor shall anything be done which may be or become an annoyance or a nuisance to the co-owners of the Condominium. No unreasonably noisy

activity shall occur in or on the common elements or in any unit at any time, and disputes among co-owners arising as a result of this provision which cannot be amicably resolved shall be arbitrated by the Association. No co-owner shall do or permit anything to be done or keep or permit to be kept in his unit or on the common elements anything that will increase the rate of insurance on the Condominium without the written approval of the Association, and each co-owner shall pay to the Association the increased insurance premiums resulting from any such activity or the maintenance of any such condition even if approved. Activities which are deemed offensive and are expressly prohibited include, but are not limited to, the following: any activity involving the use of firearms, air rifles, pellet guns, B-B guns, bows and arrows, or other similar dangerous weapons, projectiles or devices.

Section 6. Pets. Subject to the provisions of this Section 6, co-owners shall be entitled to keep pets of a domestic nature within their units. No pet or animal may be kept or bred for any commercial purpose. Pets shall have such care and restraint so as not to be obnoxious or offensive on account of noise, odor or unsanitary conditions. In the event a co-owner's pet causes unnecessary and unreasonable disturbance or annoyance to other co-owners, one or more, and such co-owner files a written complaint with the Association specifying the cause of such disturbance or annoyance, the Board of Directors, after notice and opportunity for hearing before the Board to the co-owner keeping the pet, may, if it determines that such pet is in fact causing unnecessary and unreasonable disturbance or annoyance, require the co-owner to remove the pet from his unit and the Condominium or impose such other restrictions on the keeping of such pet as are reasonable. No pet or animal may be permitted to run loose at any time upon the common elements, and any animal shall at all times be leashed and attended by some responsible person while on the common elements. No dog houses, dog runs or unattended tethering of dogs shall be allowed on any unit in the Condominium. No savage or dangerous animal shall be kept, and any co-owner who causes any animal to be brought or kept upon the condominium premises shall indemnify and hold harmless the Association for any loss, damage or liability which the Association may sustain as the result of the presence of such animal on the premises, whether or not the Association has given its permission therefor. Each co-owner shall be responsible for collection and disposition of all fecal matter disposed by any pet maintained by such co-owner. No dog which barks and can be heard on any frequent or continuing basis shall be kept in any unit or on the common elements. The Association may charge all co-owners maintaining animals a reasonable

additional assessment to be collected in the manner provided in Article II of these By-Laws in the event that the Association determines such assessment necessary to defray the maintenance cost to the Association of accommodating animals within the Condominium. The Association may, without liability to the owner thereof, remove or cause to be removed any animal from the Condominium which it determines to be in violation of the restrictions imposed by this Section. The Association shall have the right to require that any pets be registered with it and may adopt such additional reasonable rules and regulations with respect to animals as it may deem proper. In the event of any violation of this Section, the Board of Directors of the Association may assess fines for such violation in accordance with these By-Laws and in accordance with duly adopted rules and regulations of the Association.

Section 7. Aesthetics. Neither the common elements nor the condominium unit outside of the dwelling and garage, and storage shed constructed thereon shall be used for storage of supplies, materials, personal property, or trash or refuse of any kind, except as provided in duly adopted rules and regulations of the Association. Garage doors shall be kept closed at all times, except as may be reasonably necessary to carry out normal household functions (i.e., yard maintenance). In no event may garage doors be left open overnight. No unsightly condition shall be maintained on any patio, porch or deck. Only furniture and equipment consistent with the normal and reasonable use of such areas shall be permitted to remain thereon. Trash receptacles shall be maintained within the dwelling, garage or storage shed, or in an area not visible from the exterior of the unit, and shall not be permitted to remain elsewhere on the common elements, except for such short periods of time as may be reasonably necessary to permit periodical collection of trash. Neither the common elements, nor the condominium unit outside the dwelling, garage and storage shed constructed thereon shall be used in any way for the drying or airing of clothing or other fabrics, unless with the written approval of the Board of Directors. In general, no activity shall be carried out or condition maintained by the co-owner, either in his unit or upon the common elements, which is detrimental to the appearance of the Condominium.

Section 8. Vehicles. No house trailers, commercial vehicles, boat trailers, boats, camping trailers, motorcycles, all-terrain vehicles, snowmobiles, snowmobile trailers, or vehicles other than automobiles or vehicles used primarily for general personal transportation purposes may be stored upon the condominium premises, unless parked in the garage with the door closed. Temporary parking of such vehicles will be permitted only for purposes (i.e. unloading)

associated with the normal usage of such a vehicle. Such temporary parking beyond seventy-two (72) hours or habitually for lesser times will be considered as storage. No inoperative vehicles of any type may be brought or stored upon the condominium premises, either temporarily or permanently. Commercial vehicles and trucks shall not be parked in or about the Condominium except while making deliveries or pickups in the normal course of business. Co-owners shall, if the Association shall require, register with the Association all cars maintained on the condominium premises. Use of motorized vehicles anywhere on the general common elements is absolutely prohibited.

Section 9. Advertising. No signs or other advertising devices of any kind shall be displayed which are visible from the exterior of a unit or on the common elements except temporary sale signs for real estate, garage sales, yard sales, or election campaign signs, without written permission from the Association and, during the construction and sales period, from the Developer.

Section 10. Rules and Regulations. It is intended that the Board of Directors of the Association may make rules and regulations from time to time to reflect the needs and desires of the majority of the co-owners in the Condominium. Reasonable rules and regulations consistent with the Act, the Consolidated Master Deed and these By-Laws concerning the use of the common elements may be made and amended from time to time by any Board of Directors of the Association. Copies of all such rules and regulations and amendments thereto shall be furnished to all co-owners and shall become effective thirty (30) days after mailing or delivery thereof to the designated voting representative of each co-owner. Any such regulation or amendment may be revoked at any time by the affirmative vote of more than fifty percent (50%) of all co-owners in number and in value. Such rules may not be applied to limit the Developer's construction, sales or rental activities.

Section 11. Right of Access of Association. The Association or its duly authorized agents shall have access to each unit and any improvements thereon from time to time, during reasonable working hours, upon notice to the co-owner thereof, as may be necessary for the maintenance, repair or replacement of any of the common elements. The Association or its agents shall also have access to each unit and any improvements thereon at all times without notice as may be necessary to make emergency repairs to prevent damage to the common elements or to another unit or to the improvements thereon. In the event of an emergency requiring access to a unit or to the improvements thereon, the Association may gain access in such manner as may be

reasonable under the circumstances and shall not be liable to such co-owner for any necessary damage to his unit or any improvements thereon caused thereby or for repair or replacement of any doors or windows damaged gaining such access.

Section 12. Landscaping. No co-owner shall perform any landscaping or remove, trim or plant any trees, shrubs or flowers or place any ornamental materials within eight (8) feet of the exterior boundary line of the limited common element appurtenant to his unit or upon the general common elements without the prior written approval of the Association. Each co-owner shall have the responsibility to maintain the grounds of his unit and the limited common element appurtenant thereto, including the mowing of grass, removal of weeds, and proper trimming of bushes and trees. If the Association shall receive complaints from other co-owners regarding lack of maintenance of the grounds of a unit, then, and in that event, it shall have the right and duty to have such maintenance of the grounds of the unit performed as the Board of Directors shall determine as being reasonable, and the charges therefor shall become a lien upon the unit and collected in the fashion as set forth in Article II of these By-Laws.

Section 13. Common Element Maintenance. Sidewalks, yards, landscaped areas, driveways, pathways, and open spaces shall not be obstructed nor shall they be used for purposes other than that for which they are reasonably and obviously intended. No bicycles, vehicles, chairs, or other obstructions may be left unattended on or about the common elements, or they may be removed and disposed of at the discretion of the Association.

Section 14. Co-Owner Maintenance. Each co-owner shall maintain his unit and the improvements thereon in a safe, aesthetically pleasing, clean, and sanitary condition. Each co-owner shall also use due care to avoid damaging any of the common elements, including, but not limited to, the telephone, water, gas, plumbing, electrical, or other utility conduits and systems and any other common elements within any unit which are appurtenant to or which may affect any other unit. Each co-owner shall be responsible for damages or costs to the Association resulting from negligent damage to or misuse of any of the common elements by him or his family, guests, agents, or invitees, unless such damages or costs are covered by insurance carried by the Association (in which case there shall be no such responsibility unless reimbursement to the Association is limited by virtue of a deductible provision, in which case the responsible co-owner shall bear the expense to the extent of the deductible amount). Any costs or damages to the

Association may be assessed to and collected from the responsible co-owner in the manner provided in Article II hereof.

Section 15. Reserved Rights of Developer.

(a) Prior Approval by Developer. During the construction and sales period, no hedges, trees or substantial plantings or landscaping shall be installed, removed or trimmed until plans and specifications, acceptable to the Developer, showing the nature, kind, shape, height, grading or landscaping plan of the area to be affected shall have been submitted to and approved in writing by the Developer, and a copy of said plans and specifications, as finally approved, lodged permanently with the Developer.

(b) Developer's Rights in Furtherance of Development and Sales. None of the restrictions contained in this Article VI shall apply to the commercial activities or signs or billboards, if any, of the Developer during the construction and sales period or of the Association in furtherance of its powers and purposes set forth herein and in its Articles of Incorporation, as the same may be amended from time to time. Notwithstanding anything to the contrary elsewhere herein contained, the Developer shall have the right throughout the entire construction and sales period to maintain a sales office, a business office, a construction office, model units, storage areas, and reasonable parking incident to the foregoing and such access to, from and over the project as may be reasonable to enable development and sale of the entire project by the Developer. The Developer shall restore the areas so utilized to habitable status upon termination of use.

(c) Enforcement of By-Laws. The condominium project shall at all times be maintained in a manner consistent with the highest standards of a beautiful, serene, private residential community for the benefit of the co-owners and all persons interested in the Condominium. If at any time the Association fails or refuses to carry out its obligation to maintain, repair, replace, and landscape in a manner consistent with the maintenance of such high standards, then the Developer, or any entity to which it may assign this right, at its option, may elect to maintain, repair and/or replace any common elements and/or to do

any landscaping required by these By-Laws and to charge the cost thereof to the Association as an expense of administration. The Developer shall have the right to enforce these By-Laws throughout the construction and sales period notwithstanding that it may no longer own a unit in the Condominium, which right of enforcement shall include (without limitation) an action to restrain the Association or any co-owner from any activity prohibited by these By-Laws.

Section 16. Non-Disturbance Easement Behind Units 215 - 225. The City of Saline has required that the rear 22 feet of Units 215 through 225, inclusive, as shown on Exhibit "B" attached hereto, shall remain as a permanent natural non-disturbance open space area and the natural topography and vegetation shall remain undisturbed to the extent possible. The Association and all co-owners shall recognize that the City of Saline has an interest in this non-disturbance easement area and that no changes shall be made, without approval from the Association and the City of Saline, if said changes would disturb said easement area. Cutting or clearing of vegetation, other than dead or diseased trees, or removal of noxious weeds, is prohibited. Storage or dumping of any items or materials, including but not limited to vehicles, structures, building materials, trash, or refuse, is strictly prohibited. Construction of buildings, roads or other such structures is also strictly prohibited. No pesticides, herbicides or chemical fertilizers shall be used in a non-disturbance easement area, however, natural or organic fertilizer such as leaves, leaf humus, green manure, etc., may be used. Each of the affected co-owners shall be required to maintain their respective portions of the non-disturbance easement area in a proper manner so as to preserve the existing topography, vegetation, wild life habitat, and the ecological character and nature of the area, to the extent possible.

Section 17. Bus Shelter adjacent to Unit 240. Unit 240 shall be subject to an easement for the installation, repair and replacement of the bus shelter located thereon as shown on Exhibit "B" attached hereto. An access easement is specifically granted to the City of Saline and the Saline School District for access to the bus shelter for purposes of installation, maintenance, repair, and replacement. Said grantees shall exercise due care when accessing said easement whose area shall extend 10 feet to all sides of said bus shelter and restore Unit 240 to as near its original condition when completing any work done on said easement area.

Section 18. Storm Drains in the Rear of Units. Storm drains exist in the rear of some Units in the project and they are general common elements as defined in the Master Deed. The Association has the responsibility for maintaining said general common elements and shall have access over all Units in the project to maintain, repair and replace said storm drains as provided in Section 11 of Article VI hereinabove.

ARTICLE VII

MORTGAGES

Section 1. Notice to Association. Any co-owner who mortgages his unit shall notify the Association of the name and address of the mortgagee, and the Association shall maintain such information in a book entitled "Mortgages of Units". The Association may, at the written request of a mortgagee of any such unit, report any unpaid assessments due from the co-owner of such unit. The Association shall give to the holder of any first mortgage covering any unit in the project written notification of any default in the performance of the obligations of the co-owner of such unit that is not cured within sixty (60) days.

Section 2. Insurance. The Association shall notify each mortgagee appearing in said book of the name of each company insuring the general common elements against fire, perils covered by extended coverage, and against vandalism and malicious mischief, public liability, and fidelity coverage, and the amount of such coverage to the extent that the Association is obligated by the terms of these By-Laws to obtain such insurance coverage, as well as of any lapse, cancellation or material modification of any insurance policy or fidelity bond maintained by the Association.

Section 3. Notification of Meetings. Upon request submitted to the Association, any institutional holder of a first mortgage lien on any unit in the Condominium shall be entitled to receive written notification of every meeting of the members of the Association and to designate a representative to attend such meeting.

Section 4. Notice. Whenever a notice requirement appears in these By-Laws for the benefit of a mortgagee which requires a response in support of or against a proposal submitted by the Association, the mortgagee shall respond within thirty (30) days of receipt of said notice or the lack of response thereto shall be deemed as approval of the proposal.

ARTICLE VIII

VOTING

Section 1. Vote. Except as limited in these By-Laws, each co-owner shall be entitled to one vote for each condominium unit owned.

Section 2. Eligibility to Vote. No co-owner other than the Developer shall be entitled to vote at any meeting of the Association until he has presented evidence of ownership of a unit in the condominium project to the Association. Except as provided in Article XI, Section 2 of these By-Laws, no co-owner, other than the Developer, shall be entitled to vote prior to the date of the first annual meeting of members held in accordance with Section 2 of Article IX. The vote of each co-owner may be cast only by the individual representative designated by such co-owner in the notice required in Section 3 of this Article VIII or by a proxy given by such individual representative. The Developer shall be the only person entitled to vote at a meeting of the Association until the first annual meeting of members and shall be entitled to vote during such period notwithstanding the fact that the Developer may own no units at some time or from time to time during such period. At and after the first annual meeting, the Developer shall be entitled to one vote for each unit which it owns.

Section 3. Designation of Voting Representative. Each co-owner shall file a written notice with the Association designating the individual representative who shall vote at meetings of the Association and receive all notices and other communications from the Association on behalf of such co-owner. Such notice shall state the name and address of the individual representative designated, the number or numbers of the condominium unit or units owned by the co-owner, and the name and address of each person, firm, corporation, partnership, association, trust, or other entity who is the co-owner. Such notice shall be signed and dated by the co-owner. The individual representative designated may be changed by the co-owner at any time by filing a new notice in the manner herein provided.

Section 4. Quorum. The presence in person or by proxy of 30% of the co-owners qualified to vote shall constitute a quorum for holding a meeting of the members of the Association, except for voting on questions specifically required by the Condominium documents to require a greater quorum. The written vote of any person furnished at or prior to any duly called meeting at which meeting said person is not otherwise present in person or by proxy shall be counted in determining the presence of a

quorum with respect to the question upon which the vote is cast.

Section 5. Voting. Votes may be cast only in person or by a writing duly signed by the designated voting representative not present at a given meeting in person or by proxy. Proxies and any written votes must be filed with the Secretary of the Association at or before the appointed time of each meeting of the members of the Association. Cumulative voting shall not be permitted.

Section 6. Majority. A majority, except where otherwise provided herein, shall consist of more than 50% of those qualified to vote and present in person or by proxy (or written vote, if applicable) at a given meeting of the members of the Association. Whenever provided specifically herein, a majority may be required to exceed the simple majority hereinabove set forth of designated voting representatives present in person or by proxy, or by written vote, if applicable, at a given meeting of the members of the Association.

ARTICLE IX

MEETINGS

Section 1. Place of Meeting. Meetings of the Association shall be held at the principal office of the Association or at such other suitable place convenient to the co-owners as may be designated by the Board of Directors. Meetings of the Association shall be conducted in accordance with Sturgis' Code of Parliamentary Procedure, Roberts Rules of Order or some other generally recognized manual of parliamentary procedure when not otherwise in conflict with the Condominium documents or the laws of the State of Michigan.

Section 2. Annual Meetings. Annual meetings of members of the Association shall be held in the month of October of each succeeding year after the year in which the first annual meeting is held, on such date and at such time and place as shall be determined by the Board of Directors; provided, however, that the second annual meeting shall not be held sooner than eight months after the date of the first annual meeting. At such meetings there shall be elected by ballot of the co-owners a Board of Directors in accordance with the requirements of Article XI of these By-Laws. The co-owners may also transact at annual meetings such other business of the Association as may properly come before them.

Section 3. Special Meetings. It shall be the duty of the President to call a special meeting of the co-owners as directed by resolution of the Board of Directors or upon a petition signed by one-third (1/3) of the co-owners presented to the Secretary of the Association.

Notice of any special meeting shall state the time and place of such meeting and the purposes thereof. No business shall be transacted at a special meeting except as stated in the notice.

Section 4. Notice of Meetings. It shall be the duty of the Secretary (or other Association officer in the Secretary's absence) to serve a notice of each annual or special meeting, stating the purposes thereof as well as the time and place where it is to be held, upon each co-owner of record at least ten (10) days but not more than sixty (60) days prior to such meeting. The mailing, postage prepaid, of a notice to the representative of each co-owner at the address shown in the notice required to be filed with the Association by Article VIII, Section 3 of these By-Laws shall be deemed notice served. Any member may, by written waiver of notice signed by such member, waive such notice, and such waiver, when filed in the records of the Association, shall be deemed due notice.

Section 5. Adjournment. If any meeting of co-owners cannot be held because a quorum is not in attendance, the co-owners who are present may adjourn the meeting to a time not less than forty-eight (48) hours from the time the original meeting was called.

Section 6. Order of Business. The order of business at all meetings of the members shall be as follows: (a) roll call to determine the voting power represented at the meeting; (b) proof of notice of meeting or waiver of notice; (c) reading of minutes of preceding meeting; (d) reports of officers; (e) reports of committees; (f) appointment of inspectors of election (at annual meetings or special meetings held for the purpose of electing Directors or officers); (g) election of Directors (at annual meeting or special meetings held for such purpose); (h) unfinished business; and (i) new business. Meetings of members shall be chaired by the most senior officer of the Association present at such meeting. For purposes of this Section, the order of seniority of officers shall be President, Vice President, Secretary, and Treasurer.

Section 7. Action Without Meeting. Any action which may be taken at a meeting of the members (except for the election or removal of Directors) may be taken without a meeting by written ballot of the members. Ballots shall be solicited in the same manner as provided in Section 5 for the

giving of notice of meetings of members. Such solicitations shall specify (a) the number of responses needed to meet the quorum requirements; (b) the percentage of approvals necessary to approve the action; and (c) the time by which the ballots must be received in order to be counted. The form of written ballot shall afford an opportunity to specify a choice between approval and disapproval of each matter and shall provide that, where the member specifies a choice, the vote shall be cast in accordance therewith. Approval by written ballot shall be constituted by receipt, within the time period specified in the solicitation, of (i) a number of ballots which equals or exceeds the quorum which would be required if the action were taken at a meeting; and (ii) a number of approvals which equals or exceeds the number of votes which would be required for approval if the action were taken at a meeting at which the total number of votes cast was the same as the total number of ballots cast.

Section 8. Consent of Absentees. The transactions at any meeting of members, either annual or special, however called and noticed, shall be as valid as though made at a meeting duly held after regular call and notice if a quorum is present either in person or by proxy and if, either before or after the meeting, each of the members not present in person or by proxy signs a written waiver of notice or a consent to the holding of such meeting or an approval of the minutes thereof. All such waivers, consents or approvals shall be filed with the corporate records or made a part of the minutes of the meeting.

Section 9. Minutes, Presumption of Notice. Minutes or a similar record of the proceedings of meetings of members, when signed by the President or the Secretary, shall be presumed truthfully to evidence the matters set forth therein. A recitation in the minutes of any such meetings that notice of the meeting was properly given shall be prima facie evidence that such notice was given.

ARTICLE X

BOARD OF DIRECTORS

Section 1. Number and Qualification of Directors. The Board of Directors shall be composed of five (5) persons. The members of the Board of Directors must be members of the Association or officers, partners, trustees, employees, or agents of members of the Association. Directors shall serve without compensation.

Section 2. Election of Directors. The term of office of each Director shall be two years. The Directors shall hold office until their successors have been elected and

hold their first meeting. Annual meetings of co-owners to elect Directors and conduct other business shall be held in accordance with the provisions of Article IX, Section 3 hereof.

Section 3. Powers and Duties. The Board of Directors shall have the powers and duties necessary for the administration of the affairs of the Association and may do all acts and things as are not prohibited by the Condominium documents or required thereby to be exercised and done by the co-owners.

Section 4. Other Duties. In addition to the foregoing duties imposed by these By-Laws or any further duties which may be imposed by resolution of the members of the Association, the Board of Directors shall be responsible specifically for the following:

(a) To manage and administer the affairs of and to maintain the condominium project and the common elements thereof and to enforce the provisions of the Condominium documents.

(b) To levy, collect and disburse assessments against and from the members of the Association and to use the proceeds thereof for the purposes of the Association, to enforce assessments through liens and foreclosure proceedings when appropriate and to impose late charges for nonpayment of said assessments.

(c) To carry insurance and collect and allocate the proceeds thereof.

(d) To rebuild improvements to the common elements after casualty, subject to all of the other applicable provisions of the Condominium documents.

(e) To contract for and employ persons, firms, corporations, or other agents to assist in the management, operation, maintenance, and administration of the condominium project.

(f) To acquire, maintain and improve, and to buy, operate, manage, sell, convey, assign, mortgage, or lease any real or personal property (including any unit in the Condominium and easements, rights-of-way and licenses) on behalf of the Association in furtherance of any of the purposes or obligations of the Association.

(g) To borrow money and issue evidences of indebtedness in furtherance of any or all of the purposes of the Association, and to secure the same by mortgage, pledge or other lien on property owned by the Association; provided, however, that any such action shall also be approved by affirmative vote of sixty percent (60%) of all of the members of the Association.

(h) To make reasonable rules and regulations governing the use and enjoyment of the Condominium by co-owners and their tenants, guests, employees, invitees, families and pets and to enforce such rules and regulations by all legal methods, including without limitation, imposing fines and late payment charges, or instituting eviction or legal proceedings.

(i) To establish such committees as it deems necessary, convenient or desirable and to appoint persons thereto for the purpose of implementing the administration of the Condominium, and to delegate to such committees any functions or responsibilities which are not by law or the Condominium documents required to be performed by the Board.

(j) To make rules and regulations and/or to enter into agreements with institutional lenders the purposes of which are to enable unit co-owners to obtain mortgage loans which are acceptable for purchase by the Federal Home Loan Mortgage Corporation, the Federal National Mortgage Association, the Government National Mortgage Association, and/or any other agency of the Federal Government or the State of Michigan.

(k) To levy, collect and disburse fines against and from the members of the Association after notice and hearing thereon and to use the proceeds thereof for the purposes of the Association.

(l) To assert, defend or settle claims on behalf of all co-owners in connection with the common elements of the condominium project. The Board shall provide at least a ten (10) day written notice to all co-owners on actions proposed by the Board with regard thereto.

(m) To establish such committees as it deems necessary, convenient or desirable and to

appoint persons thereto for the purpose of implementing the administration of the Condominium, and to delegate to such committees any functions or responsibilities which are not by law or the Condominium documents required to be performed by the Board.

Section 5. Management Agent. The Board of Directors may employ a professional management agent for the Association (which may be the Developer or any person or entity related thereto) at reasonable compensation established by the Board to perform such duties and services as the Board shall authorize, including, but not limited to, the duties listed in Sections 3 and 4 of this Article, and the Board may delegate to such management agent any other duties or powers which are not by law or by the Condominium documents required to be performed by or have the approval of the Board of Directors or the members of the Association. In no event shall the Board be authorized to enter into any contract with a professional management agent, or any other contract providing for services by the Developer, sponsor or builder, in which the maximum term is greater than one (1) year or which is not terminable by the Association, without cause and with no termination fee, upon thirty (30) days' written notice thereof to the other party, and no such contract shall violate the provisions of Section 55 of the Act.

Section 6. Vacancies. Vacancies in the Board of Directors caused by any reason other than the removal of a Director by a vote of the members of the Association shall be filled by vote of the majority of the remaining Directors, even though they may constitute less than a quorum, except that the Developer shall be solely entitled to fill the vacancy of any Director whom it is permitted in the first instance to designate. Each person so elected shall be a Director until a successor is elected at the next annual meeting of the members of the Association.

Section 7. Removal. At any regular or special meeting of the Association duly called with due notice of the removal action proposed to be taken, any one or more of the Directors may be removed with or without cause by the affirmative vote of more than fifty percent (50%) in number and in value of all of the co-owners and a successor may then and there be elected to fill any vacancy thus created. The quorum requirement for the purpose of filling such vacancy shall be the normal thirty percent (30%) requirement set forth in Article VIII, Section 4. Any Director whose removal has been proposed by the co-owners shall be given an opportunity to be heard at the meeting. The Developer may remove and replace any or all of the

Directors selected by it at any time or from time to time in its sole discretion.

Section 8. First Meeting. The first meeting of a newly elected Board of Directors shall be held within ten (10) days of election at such place as shall be fixed by the Directors at the meeting at which such Directors were elected, and no notice shall be necessary to the newly elected Directors in order legally to constitute such meeting, providing a majority of the whole Board shall be present.

Section 9. Regular Meetings. Regular meetings of the Board of Directors may be held at such times and places as shall be determined from time to time by a majority of the Directors, but at least two (2) such meetings shall be held during each fiscal year. Notice of regular meetings of the Board of Directors shall be given to each Director personally, by mail, telephone or telegraph, at least ten (10) days prior to the date named for such meeting.

Section 10. Special Meetings. Special meetings of the Board of Directors may be called by the President on three (3) days' notice to each Director given personally, by mail, telephone or telegraph, which notice shall state the time, place and purpose of the meeting. Special meetings of the Board of Directors shall be called by the President or Secretary in like manner and on like notice on the written request of two (2) Directors.

Section 11. Waiver of Notice. Before or at any meeting of the Board of Directors, any Director may, in writing, waive notice of such meeting and such waiver shall be deemed equivalent to the giving of such notice. Attendance by a Director at any meetings of the Board shall be deemed a waiver of notice by him of the time and place thereof. If all the Directors are present at any meeting of the Board, no notice shall be required and any business may be transacted at such meeting.

Section 12. Quorum. At all meetings of the Board of Directors, a majority of the Directors shall constitute a quorum for the transaction of business, and the acts of the majority of the Directors present at a meeting at which a quorum is present shall be the acts of the Board of Directors. If, at any meeting of the Board of Directors, less than a quorum is present, the majority of those present may adjourn the meeting to a subsequent time upon twenty-four (24) hours' prior written notice delivered to all Directors not present. At any such adjourned meeting, any business which might have been transacted at the meeting as originally called may be transacted without further notice. The joinder of a Director in the action of a meeting by signing and

concurring in the minutes thereof shall constitute the presence of such Director for purposes of determining a quorum.

Section 13. First Board of Directors. The actions of the first Board of Directors of the Association or any successors thereto selected or elected before the transitional control date shall be binding upon the Association so long as such actions are within the scope of the powers and duties which may be exercised generally by the Board of Directors as provided in the Condominium documents.

Section 14. Fidelity Bonds. The Board of Directors shall require that all officers and employees of the Association handling or responsible for the funds of the Association furnish adequate fidelity bonds. The premiums on such bonds shall be expenses of administration.

ARTICLE XI

OFFICERS

Section 1. Officers. The principal officers of the Association shall be a President, who shall be a member of the Board of Directors, a Vice President, a Secretary, and a Treasurer. The Directors may appoint an Assistant Treasurer and an Assistant Secretary and such other officers as in their judgment may be necessary. Any two offices except that of President and Vice President may be held by one person.

(a) President. The President shall be the chief executive officer of the Association. He shall preside at all meetings of the Association and of the Board of Directors. He shall have all of the general powers and duties which are usually vested in the office of the President of an association, including, but not limited to, the power to appoint committees from among the members of the Association from time to time as he may in his discretion deem appropriate to assist in the conduct of the affairs of the Association.

(b) Vice President. The Vice President shall take the place of the President and perform his duties whenever the President shall be absent or unable to act. If neither the President nor the Vice President is able to act, the Board of Directors shall appoint some other member of the Board to so do on an interim basis. The Vice President shall also perform such other duties as shall from time to time be imposed upon him by the Board of Directors.

(c) Secretary. The Secretary shall keep the minutes of all meetings of the Board of Directors and the minutes of all meetings of the members of the Association; he shall have charge of the corporate seal, if any, and of such books and papers as the Board of Directors may direct; and he shall, in general perform all duties incident to the office of Secretary.

(d) Treasurer. The Treasurer shall have responsibility for the Association's funds and securities and shall be responsible for keeping full and accurate accounts of all receipts and disbursements in books belonging to the Association. He shall be responsible for the deposit of all monies and other valuable effects in the name and to the credit of the Association, and in such depositories as may, from time to time, be designated by the Board of Directors.

Section 2. Election. The officers of the Association shall be elected annually by the Board of Directors at the organizational meeting of each new Board and shall hold office at the pleasure of the Board.

Section 3. Removal. Upon affirmative vote of a majority of the members of the Board of Directors, any officer may be removed, either with or without cause, and his successor elected, at any regular meeting of the Board of Directors or at any special meeting of the Board called for such purpose. No such removal action may be taken, however, unless the matter shall have been included in the notice of such meeting. The officer who is proposed to be removed shall be given an opportunity to be heard at the meeting.

Section 4. Duties. The officers shall have such other duties, powers and responsibilities as shall, from time to time, be authorized by the Board of Directors.

ARTICLE XII

SEAL

The Association may (but need not) have a seal. If the Board determines that the Association shall have a seal, then it shall have inscribed thereon the name of the Association and the words "corporate seal", and "Michigan".

ARTICLE XIII

FINANCE

Section 1. Records. The Association shall keep detailed books of account showing all expenditures and receipts of administration and which shall specify the maintenance and repair expenses of the common elements and any other expenses incurred by or on behalf of the Association and the co-owners. Such accounts and all other Association records shall be open for inspection by the co-owners and their mortgagees during reasonable working hours. The Association shall prepare and distribute to each co-owner at least once a year a financial statement, the contents of which shall be defined by the Association. The books of account shall be audited at least annually by qualified independent auditors; provided, however, that such auditors need not be certified public accountants nor that such audit be a certified audit. Any institutional holder of a first mortgage lien on any unit in the Condominium shall be entitled to receive a copy of such annual audited financial statement within ninety (90) days following the end of the Association's fiscal year upon request therefor. The costs of any such audit and any accounting expenses shall be expenses of administration. If an audited statement is not available, any holder of a first mortgage on a unit in the project shall be allowed to have an audited statement prepared at its own expense.

Section 2. Fiscal Year. The fiscal year of the Association shall be an annual period commencing on such date as may be initially determined by the Directors. The commencement date of the fiscal year shall be subject to change by the Directors for accounting reasons or other good cause.

Section 3. Bank. Funds of the Association shall be initially deposited in such bank or savings association as may be designated by the Directors and shall be withdrawn only upon the check or order of such officers, employees or agents as are designated by resolution of the Board of Directors from time to time. The funds may be invested from time to time in accounts or deposit certificates of such bank or savings association as are insured by the Federal Deposit Insurance Corporation or the Federal Savings and Loan Insurance Corporation and may also be invested in interest-bearing obligations of the United States Government.

ARTICLE XIV

INDEMNIFICATION OF OFFICERS AND DIRECTORS

Every Director and officer of the Association shall be indemnified by the Association against all expenses and liabilities, including counsel fees, reasonably incurred by or imposed upon him in connection with any proceedings to which he may be a party or in which he may become involved by reason of his being or having been a Director or officer of the Association, whether or not he is a Director or officer at the time such expenses are incurred, except in such cases wherein the Director or officer is adjudged guilty of willful or wanton misconduct or gross negligence in the performance of his duties; provided that, in the event of any claim for reimbursement or indemnification hereunder based upon a settlement by the Director or officer seeking such reimbursement or indemnification, the indemnification herein shall apply only if the Board of Directors (with the Director seeking reimbursement abstaining) approves such settlement and reimbursement as being in the best interest of the Association. The foregoing right of indemnification shall be in addition to and not exclusive of all other rights to which such Director or officer may be entitled. At least ten (10) days prior to payment of any indemnification which it has approved, the Board of Directors shall notify all co-owners thereof. Further, the Board of Directors is authorized to carry officers' and directors' liability insurance covering acts of the officers and Directors of the Association in such amounts as it shall deem appropriate.

ARTICLE XV

AMENDMENTS

Section 1. Proposal. Amendments to these By-Laws may be proposed by the Board of Directors of the Association acting upon the vote of the majority of the Directors or may be proposed by one-third (1/3) or more of the co-owners by instrument in writing signed by them.

Section 2. Meeting. Upon any such amendment being proposed, a meeting for consideration of the same shall be duly called in accordance with the provisions of these By-Laws.

Section 3. Voting by Board of Directors. These By-Laws may be amended by an affirmative vote of a majority of the Board of Directors, provided that such amendments do not materially alter or change the rights of co-owners, mortgagees or other interested parties, and to keep these By-Laws in compliance with the Act.

Section 4. Voting By Co-Owners. These By-Laws may be amended by the co-owners at any regular annual meeting or a special meeting called for such purpose by an affirmative vote of not less than sixty-seven percent (67%) of all co-owners. No consent of mortgagees shall be required to amend these By-Laws unless such amendment would materially alter or change the rights of such mortgagees, in which event the approval of sixty-seven percent (67%) of the mortgagees shall be required, with each mortgagee to have one vote for each mortgage held. A person causing or requesting an amendment to the Condominium documents shall be responsible for costs and expenses of the amendment except for amendments based upon a vote of a prescribed majority of co-owners or based upon the Advisory Committee's decision, the costs of which are expenses of administration.

Section 5. When Effective. Any amendment to these By-Laws shall become effective upon the recording of such amendment in the office of the Washtenaw County Register of Deeds.

Section 6. Binding. A copy of each amendment to the By-Laws shall be furnished to every member of the Association after adoption; provided, however, that any amendment to these By-Laws that is adopted in accordance with this Article shall be binding upon all persons who have an interest in the project irrespective of whether such persons actually receive a copy of the amendment.

Section 7. Notice. Eligible mortgage holders, those holders of a first mortgage on a unit who have requested the Association to notify them on any proposed action that requires the consent of a specified percentage of eligible mortgage holders, also shall have the right to join in the decision making about certain amendments to the Condominium documents.

ARTICLE XVI

COMPLIANCE

The Association and all present or future co-owners, tenants or any other persons acquiring an interest in or using the project in any manner are subject to and shall comply with the Act, as amended, and the mere acquisition, occupancy or rental of any unit or an interest therein or the utilization of or entry upon the condominium premises shall signify that the Condominium documents are accepted and ratified. In the event the Condominium documents conflict with the provisions of the Act, the Act shall govern.

ARTICLE XVII

DEFINITIONS

All terms used herein shall have the same meaning as set forth in the Consolidated Master Deed to which these By-Laws are attached as an Exhibit or as set forth in the Act.

ARTICLE XVIII

REMEDIES FOR DEFAULT

Any default by a co-owner shall entitle the Association or another co-owner or co-owners to the following relief:

Section 1. Legal Action. Failure to comply with any of the terms or provisions of the Condominium documents shall be grounds for relief, which may include, without intending to limit the same, an action to recover sums due for damages, injunctive relief, foreclosure of lien (if default in payment of assessment) or any combination thereof, and such relief may be sought by the Association or, if appropriate, by an aggrieved co-owner or co-owners.

Section 2. Recovery of Costs. In any proceeding arising because of an alleged default by a co-owner, the Association, if successful, shall be entitled to recover the costs of the proceedings and such reasonable attorney's fees (not limited to statutory fees) as may be determined by the court, but in no event shall any co-owner be entitled to recover such attorney's fees.

Section 3. Removal and Abatement. The violation of any of the provisions of the Condominium documents shall also give the Association or its duly authorized agents the right, in addition to the rights set forth above, to enter upon the common elements or into any unit when reasonably necessary and summarily remove and abate, at the expense of the co-owner in violation, any structure, thing or condition existing or maintained contrary to the provisions of the Condominium documents. The Association shall have no liability to any co-owner arising out of the exercise of its removal and abatement power authorized herein.

Section 4. Assessment of Fines. The violation of any of the provisions of the Condominium documents by any co-owner shall be grounds for assessment by the Association, acting through its duly constituted Board of Directors, of monetary fines for such violations. No fine may be assessed unless rules and regulations establishing

COPY

such fine have first been duly adopted by the Board of Directors of the Association and notice thereof given to all co-owners in the same manner as prescribed in Article IX, Section 5 of these By-Laws. Thereafter, fines may be assessed only upon notice to the offending co-owners as prescribed in said Article IX, Section 5, and after an opportunity for such co-owner to appear before the Board no less than seven (7) days from the date of the notice and offer evidence in defense of the alleged violation. All fines duly assessed may be collected in the same manner as provided in Article II of these By-Laws. No fine shall be levied for the first violation. No fine shall exceed Twenty-Five Dollars (\$25.00) for the second violation, Fifty Dollars (\$50.00) for the third violation, or One Hundred Dollars (\$100.00) for any subsequent violation.

Section 5. Non-Waiver of Right. The failure of the Association or of any co-owner to enforce any right, provision, covenant, or condition which may be granted by the Condominium documents shall not constitute a waiver of the right of the Association or of any such co-owner to enforce such right, provision, covenant, or condition in the future.

Section 6. Cumulative Rights, Remedies and Privileges. All rights, remedies and privileges granted to the Association or any co-owner or co-owners pursuant to any terms, provisions, covenants, or conditions of the aforesaid Condominium documents shall be deemed to be cumulative, and the exercise of any one or more shall not be deemed to constitute an election of remedies nor shall it preclude the party thus exercising the same from exercising such other additional rights, remedies or privileges as may be available to such party at law or in equity.

Section 7. Enforcement of Provisions of Condominium Documents. A co-owner may maintain an action against the Association and its officers and Directors to compel such persons to enforce the terms and provisions of the Condominium documents. A co-owner may maintain an action against any other co-owner for injunctive relief or for damages or any combination thereof for noncompliance with the terms and provisions of the Condominium documents or the Act.

ARTICLE XIX

RIGHTS RESERVED TO DEVELOPER

Any or all of the rights and powers granted or reserved to the Developer in the Condominium documents or by law, including the right and power to approve or

disapprove any act, use or proposed action or any other matter or thing, may be assigned by it to any other entity or to the Association. Any such assignment or transfer shall be made by appropriate instrument in writing in which the assignee or transferee shall join for the purpose of evidencing its acceptance of such powers and rights, and such assignee or transferee shall thereupon have the same rights and powers as herein given and reserved to the Developer. Any rights and powers reserved by or granted to the Developer or its successors shall terminate, if not sooner assigned to the Association, at the conclusion of the construction and sales period as defined in paragraph FIRST of the Consolidated Master Deed. The immediately preceding sentence dealing with the termination of certain rights and powers granted or reserved to the Developer is intended to apply, insofar as the Developer is concerned, only to the Developer's rights to approve and control the administration of the Condominium and shall not, under any circumstances, be construed to apply to or cause the termination and expiration of any real property rights granted or reserved to the Developer or its successors and assigns in the Consolidated Master Deed or elsewhere (including, but not limited to, access easements, utility easements and all other easements created and reserved in such documents which shall not be terminable in any manner hereunder and which shall be governed only in accordance with the terms of their creation or reservation and not hereby).

ARTICLE XX

SEVERABILITY

In the event that any of the terms, provisions or covenants of these By-Laws or the Condominium documents are held to be partially or wholly invalid or unenforceable for any reason whatsoever, such holding shall not affect, alter, modify, or impair in any manner whatsoever any of the other terms, provisions or covenants of such Condominium documents or the remaining portions of any terms, provisions or covenants held to be partially invalid or unenforceable.

13:condos:nview.by2

REPLAT NO. 7 OF WASHTENAW COUNTY
CONDOMINIUM SUBDIVISION PLAN NO. 93

EXHIBIT B TO THE CONSOLIDATED
MASTER DEED OF

NORTHVIEW

A CONDOMINIUM IN THE CITY OF SALINE,
WASHTENAW COUNTY, MICHIGAN

DEVELOPER:
PETERS BUILDING COMPANY
531 BERKSHIRE DRIVE
SALINE, MICHIGAN 48176

SURVEYOR AND ENGINEER:
ATWELL-HICKS, INC.
540 AVIS DRIVE
ANN ARBOR, MICHIGAN 48106

LEGAL DESCRIPTIONS

Units 1-3 as follows:

Commencing at the W 1/4 Corner of Section 36, T3S, R5E, City of Saline, Washtenaw County, Michigan; thence S89°17'34"E 927.78 feet along the E-W 1/4 line of said section and the centerline of Saline-Waterworks Road; thence N1°30'20"W 43.03 feet for a PLACE OF BEGINNING; thence N89°17'34"W 328.00 feet; thence N0°42'28"E 127.00 feet; thence 10.91 feet along the arc of a circular curve to the right, radius 1487.00 feet, chord N0°55'13"E 10.91 feet; thence S82°47'14"E 57.52 feet; thence 268.58 feet along the arc of a circular curve to the left, radius 1751.86 feet, chord S87°08'47"E 268.31 feet; thence S1°30'20"E 121.51 feet along the west line of Colony Estates as recorded in Liber 21 of Plats, Pages 84-86, Washtenaw County Records to the Place of Beginning, being a part of the NW 1/4 of said Section 36 and containing 0.94 acres of land more or less.

Units 124-125, 228-248 and private open space as follows:

Commencing at the W 1/4 corner of Section 36, T3S, R5E, City of Saline, Washtenaw County, Michigan; thence N01°35'00"E 2508.04 feet along the west line of said Section 36 for a PLACE OF BEGINNING; thence continuing N01°35'00"E 129.99 feet along the west line of said Section 36; thence S89°27'23"E 1562.49 feet along the North line of said Section 36; thence S03°15'18"E 823.54 feet; thence S89°27'23"E 581.30 feet; thence S17°02'05"E 125.51 feet along the centerline of Ann Arbor-Saline Road; thence S72°57'50"W 35.06 feet; thence 171.14 feet along the arc of a 242.00 foot radius circular curve to the right, having a chord which bears N86°46'35"W 167.60 feet; thence 409.90 feet along the arc of a 383.00 foot radius reverse circular curve to the left, having a chord which bears S82°48'24"W 390.81 feet; thence S52°09'49"W 104.99 feet; thence N37°50'11"W 138.97 feet; thence 336.02 feet along the arc of a 687.00 foot radius circular curve to the right, having a chord which bears N23°24'16"W 332.48 feet; thence 338.09 feet along the arc of a 383.00 foot radius reverse circular curve to the left, having a chord which bears N49°13'15"W 494.92 feet; thence N89°28'10"W 936.09 feet to the Place of Beginning, being a part of the NW 1/4 of said Section 36, containing 10.84 acres of land, more or less, being subject to the rights of the public over the easterly 80.00 feet as occupied by Ann Arbor-Saline Road, subject to easements and restrictions of record, if any.

Units 11-50 as follows:

Commencing at the W 1/4 Corner of Section 36, T3S, R5E, City of Saline, Washtenaw County, Michigan; thence S89°17'34"E 927.78 feet along the E-W 1/4 line of said section and the centerline of Saline-Waterworks Road; thence along the west line of Colony Estates as recorded in Liber 21 of Plats, Pages 84-86, Washtenaw County Records the following 2 courses: N1°30'20"W 164.54 feet and N33°25'40"W 78.36 feet for a PLACE OF BEGINNING; thence 215.08 feet along the arc of a non-tangential circular curve to the right, radius 185.88 feet, chord N86°26'32"W 214.94 feet; thence N82°47'14"W 63.05 feet; thence 20.84 feet along the arc of a non-tangential circular curve to the right, radius 1487.00 feet, chord N4°07'24"E 20.84 feet; thence 131.33 feet along the arc of a reverse circular curve to the left, radius 1533.00 feet, chord N2°04'20"E 131.29 feet; thence 158.85 feet along the arc of a compound circular curve to the left, radius 783.00 feet, chord N0°07'15"W 158.59 feet; thence N79°50'00"E 40.78 feet; thence 410.85 feet along the arc of a circular curve to the left, radius 283.00 feet, chord N38°15'48"E 375.58 feet; thence 462.88 feet along the arc of a reverse circular curve to the right, radius 317.00 feet, chord N38°30'23"E 422.89 feet; thence N80°19'10"E 638.86 feet; thence 27.85 feet along the arc of a non-tangential circular curve to the right, radius 767.00 feet, chord S7°40'22"E 27.85 feet; thence 248.57 feet along the arc of a compound circular curve to the right, radius 1685.88 feet, chord S2°24'31"E 248.35 feet; thence 0.75 feet along the arc of a reverse circular curve to the left, radius 1751.86 feet, chord S1°49'41"W 0.75 feet; thence 222.89 feet along the arc of a non-tangential circular curve to the left, radius 1751.86 feet, chord S83°57'51"W 222.74 feet; thence S80°19'10"W 300.92 feet; thence 51.73 feet along the arc of a circular curve to the right, radius 75.00 feet, chord N79°55'18"W 50.71 feet; thence 293.87 feet along the arc of a reverse circular curve to the left, radius 65.00 feet, chord S9°40'50"E 100.29 feet; thence 51.73 feet along the arc of a reverse circular curve to the right, radius 75.00 feet, chord N80°33'38"E 50.71 feet; thence N80°19'10"E 300.92 feet; thence 210.92 feet along the arc of a circular curve to the right, radius 1685.88 feet, chord N83°54'13"E 210.78 feet; thence 109.90 feet along the arc of a non-tangential circular curve to the left, radius 1751.86 feet, chord S2°10'06"E 109.86 feet; thence along the north and west lines of said Colony Estates the following 8 courses: S64°07'30"W 136.53 feet, S43°55'40"W 28.98 feet, S80°41'40"W 185.94 feet, S78°54'40"W 186.26 feet, S78°54'40"W 284.46 feet, S11°59'30"W 294.70 feet, N88°31'45"W 55.00 feet and S0°05'50"E 170.00 feet to the Place of Beginning, being a part of the NW 1/4 of said Section 36 and containing 11.26 acres of land more or less.

Units 4-10, 51-55, 154-156, 173-188, 249-252 & private open space as follows:

Commencing at the W 1/4 Corner of Section 36, T3S, R5E, City of Saline, Washtenaw County, Michigan; thence S89°17'34"E 200.00 feet along the E-W 1/4 line of said Section 36 and the centerline of Saline-Waterworks Road; thence N01°35'00"E 43.00 feet for a PLACE OF BEGINNING; thence continuing N01°35'00"E 392.60 feet; thence N89°17'45"W 200.00 feet; thence N01°35'00"E 2006.45 feet along the west line of said Section 36; thence S89°28'10"E 150.00 feet; thence S01°35'00"W 129.39 feet; thence 315.13 feet along the arc of a 444.91 foot radius circular curve to the left, having a chord which bears S18°42'31"E 308.59 feet; thence S39°00'00"E 397.70 feet; thence 3.18 feet along the arc of a 583.00 foot radius circular curve to the left, having a chord which bears S39°09'23"E 3.18 feet; thence non-tangentially S47°28'35"W 113.20 feet; thence 942.00 feet along the arc of a 1035.13 foot radius circular curve to the left, having a chord which bears S21°22'17"W 909.83 feet; thence 471.54 feet along the arc of a 283.00 foot radius circular curve to the left, having a chord which bears S52°25'59"E 418.86 feet; thence N79°50'00"E 48.19 feet; thence 145.58 feet along the arc of a 717.00 foot radius non-tangential circular curve to the right, having a chord which bears S08°11'56"E 145.33 feet; thence 125.67 feet along the arc of a 1487.00 foot radius circular curve to the right, having a chord which bears S02°04'20"W 125.63 feet; thence 17.54 feet along the arc of a 1533.00 foot radius circular curve to the left, having a chord which bears S04°11'55"W 17.54 feet; thence non-tangentially N82°47'14"W 65.85 feet; thence 51.73 feet along the arc of a 75.00 foot radius circular curve to the right, having a chord which bears N83°01'42"W 50.71 feet; thence 293.87 feet along the arc of a 65.00 foot radius circular curve to the left, having a chord which bears S07°12'46"W 100.29 feet; thence 51.73 feet along the arc of a 75.00 foot radius circular curve to the right, having a chord which bears N77°27'14"E 50.71 feet; thence S82°47'14"E 71.13 feet; thence 18.43 feet along the arc of a 1533.00 foot radius non-tangential circular curve to the left, having a chord which bears S01°03'06"W 18.43 feet; thence S00°42'28"W 127.00 feet; thence N89°17'34"W 331.48 feet to the Place of Beginning, being a part of the NW 1/4 of said Section 36, containing 14.12 acres of land, more or less, being subject to easement and restrictions of record, if any.

AS-BUILT DATE - FEBRUARY 29, 1998

ROBERT C. MACOMBER
PROFESSIONAL SURVEYOR NO. 27453
ATWELL-HICKS, INC.
540 AVIS DRIVE
ANN ARBOR, MICHIGAN 48106
TELEPHONE - (313) 994-6000



SHEET INDEX:

SHEET NO.	DESCRIPTION	DRAWING NO.
•1	TITLE AND DESCRIPTIONS	138-181
•1A	DESCRIPTIONS	138-191A
•1B	DESCRIPTIONS	138-191B
•2	COMPOSITE PLAN	138-192
•3	SURVEY AND SITE PLAN PHASE I (UNITS 1-13)	138-193
•3A	SURVEY AND SITE PLAN PHASE I (UNITS 14-29)	138-193A
•3B	SURVEY AND SITE PLAN PHASE II (UNITS 30-41 AND 66-81)	138-193B
•3C	SURVEY AND SITE PLAN PHASE II (UNITS 42-65 AND 252)	138-193C
•3D	SURVEY AND SITE PLAN PHASE IIIA (UNITS 82-108)	138-193D
•3E	SURVEY AND SITE PLAN PHASE IIIB (UNITS 159-156)	138-193E
•3F	SURVEY AND SITE PLAN PHASE IIIB (UNITS 107-116 AND 128-138)	138-193F
•3G	SURVEY AND SITE PLAN PHASE IIIB (UNITS 117-127)	138-193G
•3H	SURVEY AND SITE PLAN PHASE IIIB PRIVATE OPEN SPACE	138-193H
•3I	SURVEY AND SITE PLAN PHASE V (UNITS 189-208)	138-193I
•3J	SURVEY AND SITE PLAN PHASE IV (UNITS 157-188 AND 249-251)	138-193J
•3K	SURVEY AND SITE PLAN PHASE VI (UNITS 207-214 AND 240-248)	138-193KH
•3L	SURVEY AND SITE PLAN PHASE VI (UNITS 215-239)	138-193L
••3M	SURVEY AND SITE PLAN PRIVATE OPEN SPACE	138-193M
•4	COORDINATE LISTING	138-194
•4A	COORDINATE LISTING	138-194A
•5	UTILITY PLAN PHASE I (UNITS 1-13)	138-195
•5A	UTILITY PLAN PHASE I (UNITS 14-29)	138-195A
•5B	UTILITY PLAN PHASE II (UNITS 30-41 AND 66-81)	138-195B
•5C	UTILITY PLAN PHASE II (UNITS 42-65 AND 252)	138-195C
•5D	UTILITY PLAN PHASE IIIA (UNITS 82-108)	138-195D
•5E	UTILITY PLAN PHASE IIIB (UNITS 139-156)	138-195E
•5F	UTILITY PLAN PHASE IIIB (UNITS 107-116 AND 128-138)	138-195F
•5G	UTILITY PLAN PHASE IIIB (UNITS 117-127)	138-195G
•5H	UTILITY PLAN PHASE V (UNITS 189-208)	138-195H
•5I	UTILITY PLAN PHASE IV (UNITS 157-188 AND 249-251)	138-195I
•5J	UTILITY PLAN PHASE VI (UNITS 207-241 AND 240-248)	138-195J
•5K	UTILITY PLAN PHASE VI (UNITS 215-239)	138-195K
••5L	UTILITY PLAN PRIVATE OPEN SPACE	138-195L
•6	TYPICAL UNIT CROSS SECTION	138-196

• INDICATES A SHEET HAS BEEN REVISED OR REPLACED.
•• INDICATES A NEW SHEET HAS BEEN ADDED.

TITLE AND DESCRIPTIONS
NORTHVIEW

1

CLIENT: PETERS BUILDING COMPANY	SECTION 36 TOWN 3 SOUTH RANGE 5 EAST	ATWELL-HICKS, INC. CIVIL ENGINEER, SURVEYOR, PLANNER ANN ARBOR (313) 994-6000
CITY OF SALINE WASHTENAW COUNTY, MICHIGAN	DRAWN BY: [Signature]	CHECKED BY: [Signature]
DATE: 02/27/98	SCALE: AS SHOWN	DATE: 02/27/98
PROJECT NO: 98099-03		

LIBER 03320 PAGE 0664
PAGE 34 OF 67
COPY

UNITS 58-79 AND 88-119 AS FOLLOWS:

Commencing at the W 1/4 Corner of Section 36, T3S, R5E, City of Saline, Washtenaw County, Michigan; thence S89°17'34"E 200.00 feet along the E-W 1/4 line of said Section 36 and the centerline of Saline-Waterworks Road; thence N01°35'00"E 435.60 feet; thence N89°17'45"W 200.00 feet; thence N01°35'00"E 10.00 feet along the west line of said Section 36; thence N49°21'26"E 270.47 feet; thence N51°47'33"E 68.08 feet; thence N48°36'57"E 126.58 feet; thence S50°40'26"E 38.62 feet; thence S61°31'20"E 48.27 feet; thence N78°49'37"E 57.69 feet; thence N12°01'27"W 7.88 feet; thence N77°58'33"E 66.00 feet for a PLACE OF BEGINNING; thence 676.92 feet along the arc of a circular curve to the right, radius 643.00 feet, chord bearing N18°08'06"E 646.09 feet; thence 201.45 feet along the arc of a 408.00 foot radius circular curve to the left, chord bearing N34°08'57"E 199.41 feet; thence 248.42 feet along the arc of a 583.00 foot radius non-tangential circular curve to the left, chord bearing S87°16'38"E 246.55 feet; thence N83°30'55"E 234.61 feet; thence 195.13 feet along the arc of a 394.33 foot radius circular curve to the left, chord bearing N66°20'22"E 193.14 feet; thence N52°09'49"E 82.54 feet; thence S37°50'11"E 32.66 feet; thence 323.83 feet along the arc of a 767.00 foot radius circular curve to the right, chord S25°44'29"E 321.43 feet; thence S80°19'10"W 637.14 feet; thence 559.01 feet along the arc of a circular curve to the left, radius 383.00 feet, chord bearing S38°30'23"W 510.70 feet; thence 314.88 feet along the arc of a circular curve to the right, radius 217.00 feet, chord bearing S38°15'48"W 287.98 feet; thence S79°50'00"W 42.92 feet; thence N12°01'27"W 124.58 feet to the Place of Beginning, being a part of the NW 1/4 of said Section 36, containing 9.45 acres of land, more or less, and being subject to easements of record, if any.

Units 126-153, 189-225

Commencing at the W 1/4 Corner of Section 36, T3S, R5E, City of Saline, Washtenaw County, Michigan; thence S89°17'34"E 200.00 feet along the E-W 1/4 line of said Section 36 and the centerline of Saline-Waterworks Road; thence N01°35'00"E 435.60 feet; thence N89°17'45"W 200.00 feet; thence N01°35'00"E 2008.45 feet along the West line of said Section 36; thence S89°28'10"E 216.01 feet for a PLACE OF BEGINNING; thence continuing S89°28'10"E 721.29 feet; thence 445.37 feet along the arc of a 317.00 foot radius circular curve to the right, having a chord which bears S49°13'15"E 409.63 feet; thence 389.27 feet along the arc of a 733.00 foot radius reverse circular curve to the left, having a chord which bears S23°24'16"E 365.37 feet; thence S37°50'11"E 138.97 feet; thence S52°09'49"E 82.54 feet; thence 182.47 feet along the arc of a 328.33 foot radius circular curve to the right, having a chord which bears S66°20'22"W 160.82 feet; thence S80°30'56"W 75.86 feet; thence N09°29'04"W 101.85 feet; thence 144.17 feet along the arc of a 263.00 foot radius circular curve to the left, having a chord which bears N25°11'22"W 142.36 feet; thence 115.22 feet along the arc of a 301.55 foot radius reverse circular curve to the right, having a chord which bears N29°58'46"W 114.52 feet; thence N15°00'00"W 125.40 feet; thence 38.22 feet along the arc of a 50.00 foot radius circular curve to the right, having a chord which bears N02°54'03"E 37.30 feet; thence 303.59 feet along the arc of a 65.00 foot radius reverse circular curve to the left, having a chord which bears S71°00'00"W 93.83 feet; thence 38.22 feet along the arc of a 50.00 foot radius reverse circular curve to the right, having a chord which bears S40°54'03"E 37.30 feet; thence S19°00'00"E 92.40; thence S71°00'00"W 53.93 feet; thence 55.57 feet along the arc of a 50.00 foot radius circular curve to the right, having a chord which bears N77°09'47"W 52.75 feet; thence 276.44 feet along the arc of a 65.00 foot radius reverse circular curve to the left, having a chord which bears S12°50'15"W 110.44 feet; thence N71°00'00"E 158.48 feet; thence 107.39 feet along the arc of a 367.55 foot radius circular curve to the left, having a chord which bears S32°31'16"E 107.01 feet; thence 107.99 feet along the arc of a 197.00 foot radius circular curve to the right, having a chord which bears S25°11'16"E 106.64 feet; thence S09°29'04"E 101.84 feet; thence S80°30'56"W 92.74 feet; thence 545.77 feet along the arc of a 517.00 foot radius circular curve to the right, having a chord which bears N89°14'32"W 520.78 feet; thence N39°00'00"W 287.48 feet; thence N51°00'00"E 143.93 feet; thence 55.57 feet along the arc of a 50.00 foot radius circular curve to the right, having a chord which bears N82°50'13"E 52.75 feet; thence 276.44 feet along the arc of a 65.00 foot radius reverse circular curve to the left, having a chord which bears N07°09'47"W 110.44 feet; thence S51°00'00"W 247.00 feet; thence N39°00'00"W 64.24 feet; thence 288.38 feet along the arc of a chord which bears N18°42'30"W 282.81 feet; thence N01°35'00"E 130.60 feet to the Place of Beginning, being a part of the NW 1/4 of said Section 36, containing 15.73 acres of land, more or less, and being subject to easements and restrictions of record, if any.

Units 56-58, 82-95 and 157-172 as follows:

Commencing at the W 1/4 corner of Section 36, T3S, R5E, City of Saline, Washtenaw County, Michigan; thence N01°35'00"E 2442.03 feet along the West line of said Section 36; thence S89°28'10"E 150.00 feet; thence S01°35'00"W 129.39 feet; thence 315.13 feet along the arc of a 444.91 foot radius circular curve to the left, having a chord which bears S18°42'31"E 308.59 feet; thence S39°00'00"E 397.70 feet; thence 69.22 feet along the arc of a 583.00 foot radius circular curve to the left, having a chord which bears S42°24'05"E 69.19 feet for a PLACE OF BEGINNING; thence continuing 231.73 feet along the arc of a 583.00 foot radius circular curve to the left, having a chord which bears S57°11'22"E 230.21 feet; thence 166.76 feet along the arc of a 342.00 foot radius non-tangential circular curve to the right, having a chord which bears S34°19'33"W 165.11 feet; thence 746.40 feet along the arc of a 709.00 foot radius reverse circular curve to the left, having a chord which bears S18°08'06"W 712.41 feet; thence S12°01'27"E 122.42 feet; thence non-tangentially S79°50'00"W 44.05 feet; thence 361.57 feet along the arc of a 217.00 foot radius circular compound curve to the right, having a chord which bears N52°25'58"W 321.17 feet; thence 881.94 feet along the arc of a 969.13 foot radius circular curve to the right, having a chord which bears N21°22'16"E 851.82 feet; thence N47°28'30"E 113.20 feet to the Place of Beginning, being in the NW 1/4 of said Section 36, containing 6.46 acres of land, more or less, being subject to easements and restrictions of record, if any.

Units 80, 81, and Units 120-123 as follows:

Commencing at the W 1/4 corner of Section 36, T3S, R5E, City of Saline, Washtenaw County, Michigan; thence N01°35'00"E 2442.04 feet along the west line of said Section 36; thence S89°28'10"E 216.01 feet; thence S01°35'00"W 130.80 feet; thence 268.38 feet along the arc of a 378.91 foot radius circular curve to the left, chord bearing S18°42'30"E 282.81 feet; thence S39°00'00"E 397.71 feet; thence 545.77 feet along the arc of a 517.00 foot radius circular curve to the left, chord bearing S69°14'32"E 520.78 feet; thence N80°30'56"E 234.60 feet; thence 162.47 feet along the arc of a 328.33 foot radius circular curve to the left, chord bearing N66°20'22"E 180.82 feet; thence N52°09'49"E 148.54 feet; thence S37°50'11"E 68.00 feet for a PLACE OF BEGINNING; thence N52°09'49"E 104.99 feet; thence 25.02 feet along the arc of a 317.00 foot radius circular curve to the right, chord bearing N54°25'29"E 25.01 feet; thence S36°58'43"E 80.27 feet; thence S32°55'11"E 68.43 feet; thence S28°50'55"E 68.43 feet; thence S24°48'29"E 68.43 feet; thence S20°42'09"E 68.43 feet; thence S16°37'48"E 68.43 feet; thence S75°24'23"W 130.00 feet; thence 337.93 feet along the arc of a 833.00 foot radius circular curve to the left, chord bearing N26°12'54"W 335.81 feet; thence N37°50'11"W 32.86 feet to the Place of Beginning, being a part of the NW 1/4 of said Section 36, containing 1.18 acres of land, more or less, being subject to easements and restrictions of record, if any.



AS-BUILT DATE - FEBRUARY 29, 1996
 ROBERT G. MACOMBER
 PROFESSIONAL SURVEYOR NO. 27453
 ATWELL-HICKS, INC.
 540 AVIS DRIVE
 ANN ARBOR, MICHIGAN 48106
 TELEPHONE - (313) 994-4000

**DESCRIPTIONS
 NORTHVIEW**

1A

CLIENT: PETERS BUILDING COMPANY	SECTION 36 TOWN 3 SOUTH RANGE 5 EAST CITY OF SALINE WASHTENAW COUNTY, MICHIGAN	ATWELL-HICKS, INC. ANN ARBOR (313) 994-4000
DATE: 02/29/96	SCALE: 1" = 40' FEET UNLESS OTHERWISE NOTED	DATE: 02/29/96 FILE NO. 138-191A

LIBRARY
 05220 Page 0665
 PAGE 35 OF 67
 COPY

PRIVATE OPEN SPACE AS FOLLOWS:

Commencing at the W 1/4 corner of Section 36, T3S, R5E, City of Saline, Washtenaw County Michigan; thence N01°35'00"E 2638.04 feet along the West line of said section 36; thence S89°28'10"E 1563.33 feet along the North line of said Section 36; thence S03°29'00"E 621.21 feet; thence S89°28'10"E 558.19 feet; thence S17°02'10"E 194.33 feet along the center line of Ann Arbor-Saline Road for a PLACE OF BEGINNING; thence along the northerly line of Woodland Drive the following 3 courses: S72°57'50"W 36.02 feet, 217.82 feet along the arc of a tangential circular curve to the right, radius 308.00 feet chord bearing N86°46'35"W 213.31 feet and 314.24 feet along the arc of a tangential circular curve to the left, radius 317.00 feet chord bearing S85°05'04"W 301.53 feet; thence S36°58'43"E 80.27 feet; thence S32°55'11"E 88.43 feet; thence S28°50'50"E 88.43 feet; thence S24°46'29"E 88.43 feet; thence S20°42'09"E 88.43 feet; thence S16°37'48"E 88.43 feet; thence S75°24'23"W 130.00 feet; thence along the easterly line of Colony Drive the following 3 courses: 115.74 feet along arc of a tangential circular curve to the right, radius 833.00 feet chord bearing S10°36'47"E 115.85 feet, 258.30 feet along the arc of a tangential circular curve to the right, radius 1751.86 feet chord bearing S02°24'31"E 258.07 feet, and 115.95 feet along the arc of a tangential circular curve to the left, radius 1885.88 feet chord bearing S00°09'18"E 115.92 feet; thence N78°15'10"E 200.00 feet; thence S06°56'15"E 89.14 feet; thence S89°17'45"E 40.02 feet; thence N12°40'10"W 74.60 feet; thence N77°19'50"E 260.80 feet; thence N12°40'10"W 360.00 feet; thence N77°19'50"E 175.00 feet; thence N12°40'10"W 135.38 feet along the center line of Ann Arbor-Saline Road; thence N17°02'10"W 328.89 feet continuing along the center line of Ann Arbor-Saline Road to the Place of Beginning; being a part of the N 1/2 of said Section 36, containing 9.85 acres of land, more or less, being subject to the rights of the public over the easterly 60.00 feet thereof as occupied by Ann Arbor-Saline Road, subject to easements and restrictions of record, if any.

EASEMENT FOR WATERMAIN AS FOLLOWS:

Commencing at the W 1/4 corner of Section 36, T3S, R5E, City of Saline, Washtenaw County, Michigan; thence N01°35'00"E 2442.04 feet along the west line of said Section 36; thence S89°28'10"E 216.01 feet; thence S01°35'00"W 130.60 feet; thence 268.38 feet along the arc of a 378.91 foot radius circular curve to the left, chord bearing S18°42'30"E 262.81 feet; thence S39°00'00"E 397.71 feet; thence 545.77 feet along the arc of a 517.00 foot radius circular curve to the left, chord bearing S69°14'32"E 520.78 feet; thence N80°30'56"E 234.60 feet; thence 182.47 feet along the arc of a 328.33 foot radius circular curve to the left, chord bearing N86°20'22"E 160.82 feet; thence N52°09'49"E 253.53 feet; thence 48.83 feet along the arc of a circular curve to the right, radius 383.00 feet, chord bearing N55°48'03"E 48.59 feet for a PLACE OF BEGINNING; thence N03°55'51"E 89.15 feet; thence N71°25'51"E 98.24 feet; thence S83°34'09"E 104.39 feet; thence 57.44 feet along the arc of a non-tangential circular curve to the left, radius 383.00 feet, chord bearing S84°54'40"W 57.38 feet; thence N83°34'09"W 43.05 feet; thence S71°25'51"W 83.78 feet; thence S03°55'51"W 30.47 feet; thence 35.33 feet along the arc of a non-tangential circular curve to the left, radius 383.00 feet, chord bearing S82°04'50"W 35.32 feet to the Place of Beginning, being a part of the NW 1/4 of said Section 36, containing 0.14 acres of land, more or less, being subject to easements and restrictions of record, if any.

EASEMENT FOR DRAINAGE AS FOLLOWS:

Commencing at the W 1/4 Corner of Section 36, T3S, R5E, City of Saline, Washtenaw County, Michigan; thence S89°17'34"E 927.78 feet along the E-W 1/4 line and the centerline of Saline-Waterworks Road; thence along the west line of Colony Estates subdivision as recorded in Liber 21 of Plats, Pages 84-86, Washtenaw County Records the following 5 courses: N01°30'20"W 164.54 feet, N33°25'40"W 78.36 feet, N00°05'50"W 170.00 feet, S86°31'45"E 55.00 feet and N11°59'30"E 294.70 feet; thence N02°00'00"W 185.82 feet; thence N08°54'45"E 110.00 feet; thence N51°32'13"E 122.00 feet; thence N80°19'10"E 483.00 feet; thence N83°41'17"E 95.08 feet; thence N86°18'17"E 185.07 feet for a PLACE OF BEGINNING; thence 121.95 feet along the arc of a nontangential circular curve to the left, radius 1751.86 feet, chord N04°38'18"W 121.93 feet; thence 115.74 feet along the arc of a circular curve to the left, radius 833.00 feet, chord bearing N10°36'47"W 115.85 feet; thence nontangentially N75°24'23"E 197.21 feet; thence S08°24'54"E 246.83 feet; thence S78°15'10"W 200.00 feet to the place of beginning, being a part of the NW 1/4 of said section 36, containing 1.07 acres of land more or less.



AS-BUILT DATE - FEBRUARY 29, 1998

ROBERT G. MACOMBER
PROFESSIONAL SURVEYOR NO. 27453
ATWELL-HICKS, INC.
540 AVIS DRIVE
ANN ARBOR, MICHIGAN 48106
TELEPHONE - (313) 994-4000


**DESCRIPTIONS
NORTH-VIEW**

1B

CLIENT: PETERS BUILDING COMPANY	SECTION 36 TOWN 3 SOUTH RANGE 5 EAST CITY OF SALINE WASHTENAW COUNTY, MICHIGAN	ATWELL-HICKS, INC. CIVIL ENGINEERS, SURVEYORS, PLANNERS ANN ARBOR (313) 994-4000
DATE: 02/02/98	SCALE: 1" = 40 FEET	DATE: 02/02/98
BOOK: 138-191B	DATE: 02/02/98	DATE: 02/02/98

LIBR 03320 PAGE 0666
PAGE 36 OF 67
COPY


UNITS 1-252

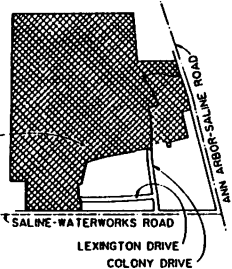

AREA CHART

UNIT	AREA
1	13,288 S.F.
2	13,540 S.F.
3	13,891 S.F.
4	13,459 S.F.
5	13,857 S.F.
6	20,465 S.F.
7	12,333 S.F.
8	12,096 S.F.
9	12,702 S.F.
10	12,298 S.F.
11	12,632 S.F.
12	12,554 S.F.
13	12,056 S.F.

VICINITY MAP

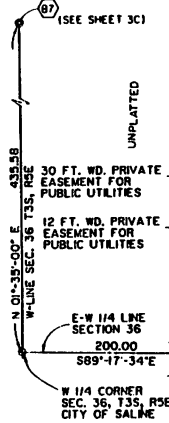


CURVE CHART

CURVE	ARC LENGTH	RADIUS	DELTA	CHORD	
				BEARING	LENGTH
1	18.43	1533.00	00°41'19"	N1°03'06"E	18.43
2	51.73	75.00	39°31'04"	S77°27'14"W	50.71
3	293.87	65.00	259°02'07"	N07°12'46"E	100.29
4	51.73	75.00	39°31'04"	S63°01'42"E	50.71
5	17.54	1533.00	00°39'20"	N04°11'55"E	17.54
6	125.67	3467.00	04°54'30"	N02°04'20"E	125.63
7	122.53	1533.00	04°34'46"	S02°14'12"W	122.50
8	20.64	1857.00	00°48'22"	S04°37'24"W	20.64
9	217.08	1695.86	07°18'25"	S86°26'33"E	214.94
10	266.56	1751.86	08°43'05"	N87°08'47"W	266.31
11	10.91	1487.00	00°25'14"	S00°55'13"W	10.91

LEGEND:

- (8) INDICATES CURVE NUMBER
- (22) INDICATES COORDINATE POINT, (SEE SHEET 4 FOR LIST)

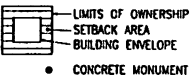

BEARINGS ARE RELATED TO THE PLAT OF COLONY ESTATES AS RECORDED IN LIBER 21 OF PLATS, PAGES 84-86, WASHTENAW COUNTY RECORDS.

SURVEY & SITE PLAN PHASE 1 (UNITS 1-13) NORTHVIEW

SURVEYOR'S CERTIFICATE

I, ROBERT G. MACOMBER, LICENSED LAND SURVEYOR OF THE STATE OF MICHIGAN HEREBY CERTIFY:

THAT THE SUBDIVISION PLAN KNOWN AS WASHTENAW COUNTY CONDOMINIUM SUBDIVISION PLAN NO. 93 AS SHOWN ON THE ACCOMPANYING DRAWINGS, REPRESENT A SURVEY ON THE GROUND MADE UNDER MY DIRECTION, THAT THERE ARE NO EXISTING ENCROACHMENTS UPON THE LANDS AND PROPERTY HEREIN DESCRIBED.

THAT THE REQUIRED MONUMENTS AND IRON MARKERS WILL BE LOCATED IN THE GROUND AS REQUIRED BY THE RULES PROMULGATED UNDER SECTION 142 OF ACT NO. 59 OF PUBLIC ACTS OF 1978, BY APRIL 15, 1995.

THAT THE ACCURACY OF THIS SURVEY IS WITHIN THE LIMITS REQUIRED BY THE RULES PROMULGATED UNDER SECTION 142 OF ACT NO. 59 OF PUBLIC ACTS OF 1978.

DATE JULY 29, 1996

AS BUILT DATE - FEBRUARY 29, 1996

ROBERT G. MACOMBER
PROFESSIONAL SURVEYOR NO. 27453
ATWELL-HICKS, INC.
640 AVIS DRIVE
ANN ARBOR, MICHIGAN 48108
TELEPHONE - (313) 994-4000

CLIENT: PETRES BUILDING COMPANY	SECTION 36, TOWN 3 SOUTH RANGE 8 EAST CITY OF SALINE SALINE, MICHIGAN	ATWELL-HICKS, INC. CIVIL ENGINEERS SURVEYORS PLANNERS ANN ARBOR
DATE: JULY 29, 1996	DR. JIMM CH. EM. BOOK SCALE: 1" = 40' FEET DIVISION: 8' FEET	DATE: 2-29-96 JOB NUMBER 138-193

LIBER 053270 PAGE 0668
PAGE 38 OF 67
COPY

UNIT	AREA	S.F.
14	12,035	S.F.
15	11,700	S.F.
16	11,701	S.F.
17	11,700	S.F.
18	11,700	S.F.
19	11,700	S.F.
20	13,319	S.F.
21	20,500	S.F.
22	16,897	S.F.
23	11,707	S.F.
24	11,763	S.F.
25	11,767	S.F.
26	11,767	S.F.
27	11,902	S.F.
28	11,992	S.F.
29	12,286	S.F.



CURVE	ARC LENGTH	RADIUS	DELTA	CHORD	
				BEARING	LENGTH
12	109.99	1751.86	03°35'40"	N02°10'06"W	109.89
13	219.92	1682.86	07°10'06"	S83°54'13"W	210.78
14	51.72	75.00	39°31'03"	S60°33'28"W	50.71
15	231.87	65.00	259°02'07"	N09°40'50"W	100.29
16	51.72	75.00	39°31'03"	S79°58'18"W	50.71
17	222.69	1751.86	07°17'23"	N83°57'53"E	222.74
18	0.72	1751.86	00°01'28"	N01°49'43"E	0.75
19	130.00	1682.86	04°25'05"	N00°25'31"W	129.97

LEGEND:

(8) INDICATES CURVE NUMBER

(22) INDICATES COORDINATE POINT, (SEE SHEET 4 FOR LIST)

BEARINGS ARE RELATED TO THE PLAT OF COLONY ESTATES AS RECORDED IN LIBER 21 OF PLATS, PAGES 84-86, WASHTENAW COUNTY RECORDS.

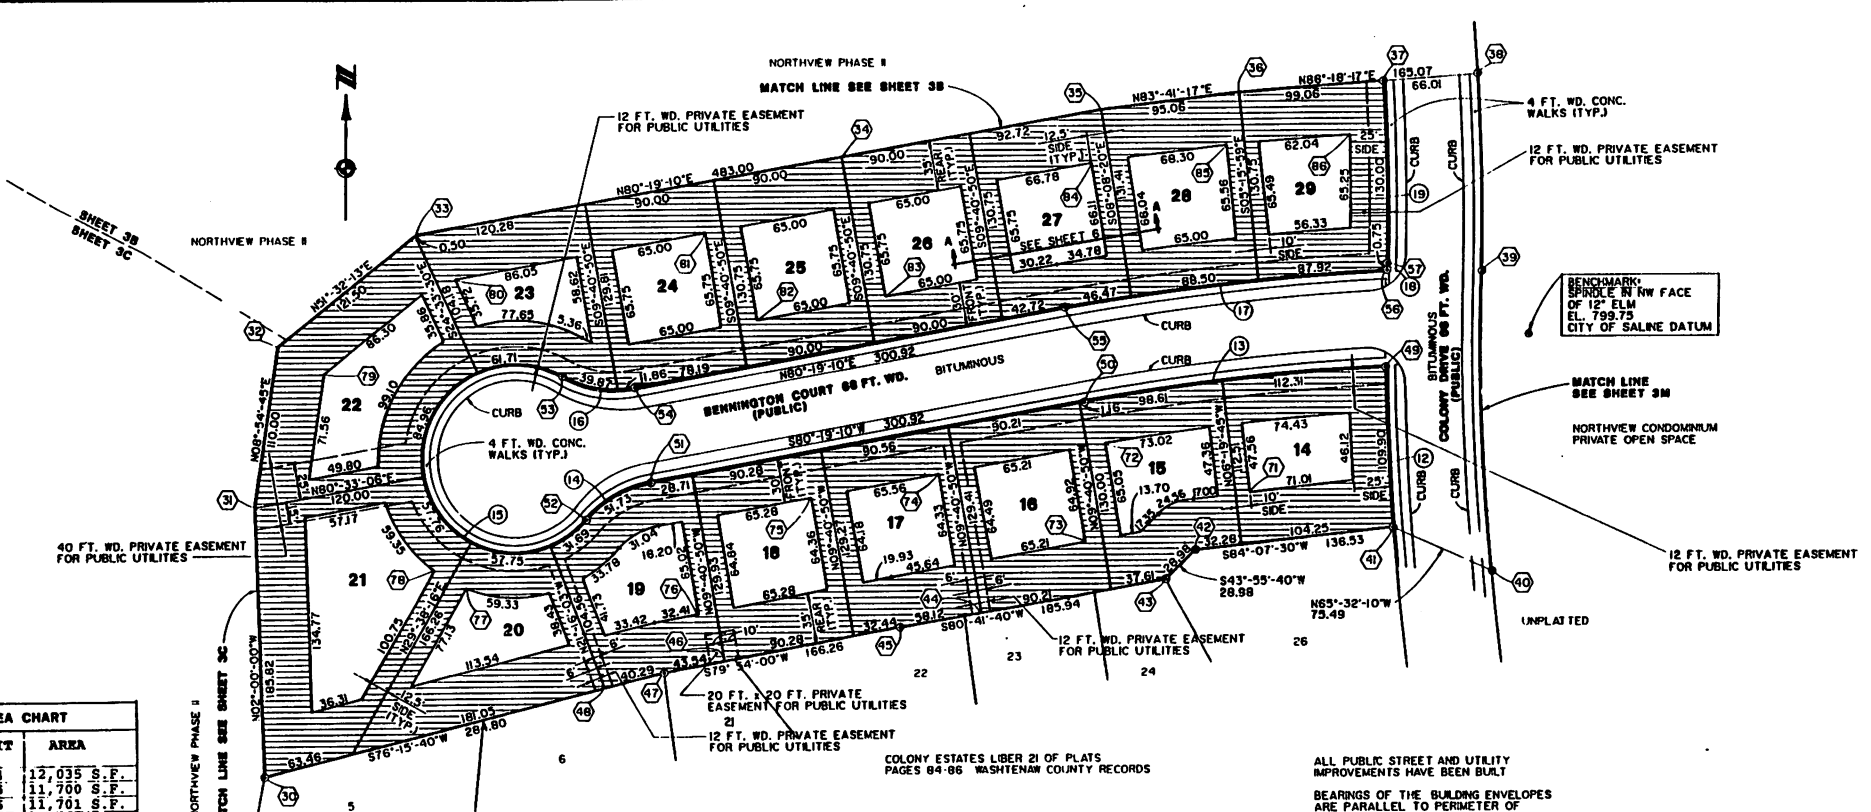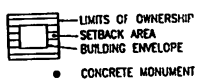

ROBERT G. MACOMBER
 PROFESSIONAL SURVEYOR NO. 27453
 ATWELL-HICKS, INC.
 540 AVIS DRIVE
 ANN ARBOR, MICHIGAN 48108
 TELEPHONE - (313) 994-4000



SURVEY & SITE PLAN PHASE 1 (UNITS 14-29) NORTHVIEW

3A

CLIENT: PETERS BUILDING COMPANY	SECTION: 2ND TOWN & SOUTH RANGE 0 EAST	ATWELL-HICKS, INC.
	CITY OF GALLIA	CIVIL ENGINEER SURVEYOR LICENSE NO. 212 286-0000
	WASHTENAW COUNTY, MICHIGAN	DATE: 2-29-96
		DR. JOHN CH. EPH. REG. NUMBER
		BOOK
		JOB NO. 90990
		138-193A


LIBER 03220 Page 0669

Page 39 of 67

copy

AREA CHART:	
UNIT	AREA
30	10,730.00
31	9,492.00
32	9,189.00
33	9,099.00
34	9,100.00
35	9,100.00
36	9,100.00
37	9,100.00
38	9,100.00
39	9,102.00
40	9,103.00
41	9,102.00
66	9,966.00
67	9,966.00
68	9,884.00
69	9,884.00
70	9,884.00
71	9,122.00
72	9,100.00
73	9,100.00
74	9,100.00
75	9,100.00
76	9,100.00
77	9,100.00
78	9,100.00
79	9,185.00
80	8,269.00
81	8,269.00

CURVE CHART:						
CURVE	ARC LENGTH	RADIUS	DELTA	BEARING	CHORD LENGTH	
20	118.57	1685.86	04°01'47"	S04°37'04"E	118.55	
21	27.85	767.00	02°04'49"	S07°40'22"E	27.85	
22	323.43	767.00	24°11'24"	S25°44'29"E	321.43	
23	462.68	317.00	83°37'35"	N38°30'23"E	422.69	
24	559.01	183.00	83°37'35"	S38°30'23"W	510.70	
39	118.42	833.00	08°08'42"	N18°39'58"W	118.32	
40	337.93	833.00	23°14'34"	N26°12'54"W	339.61	

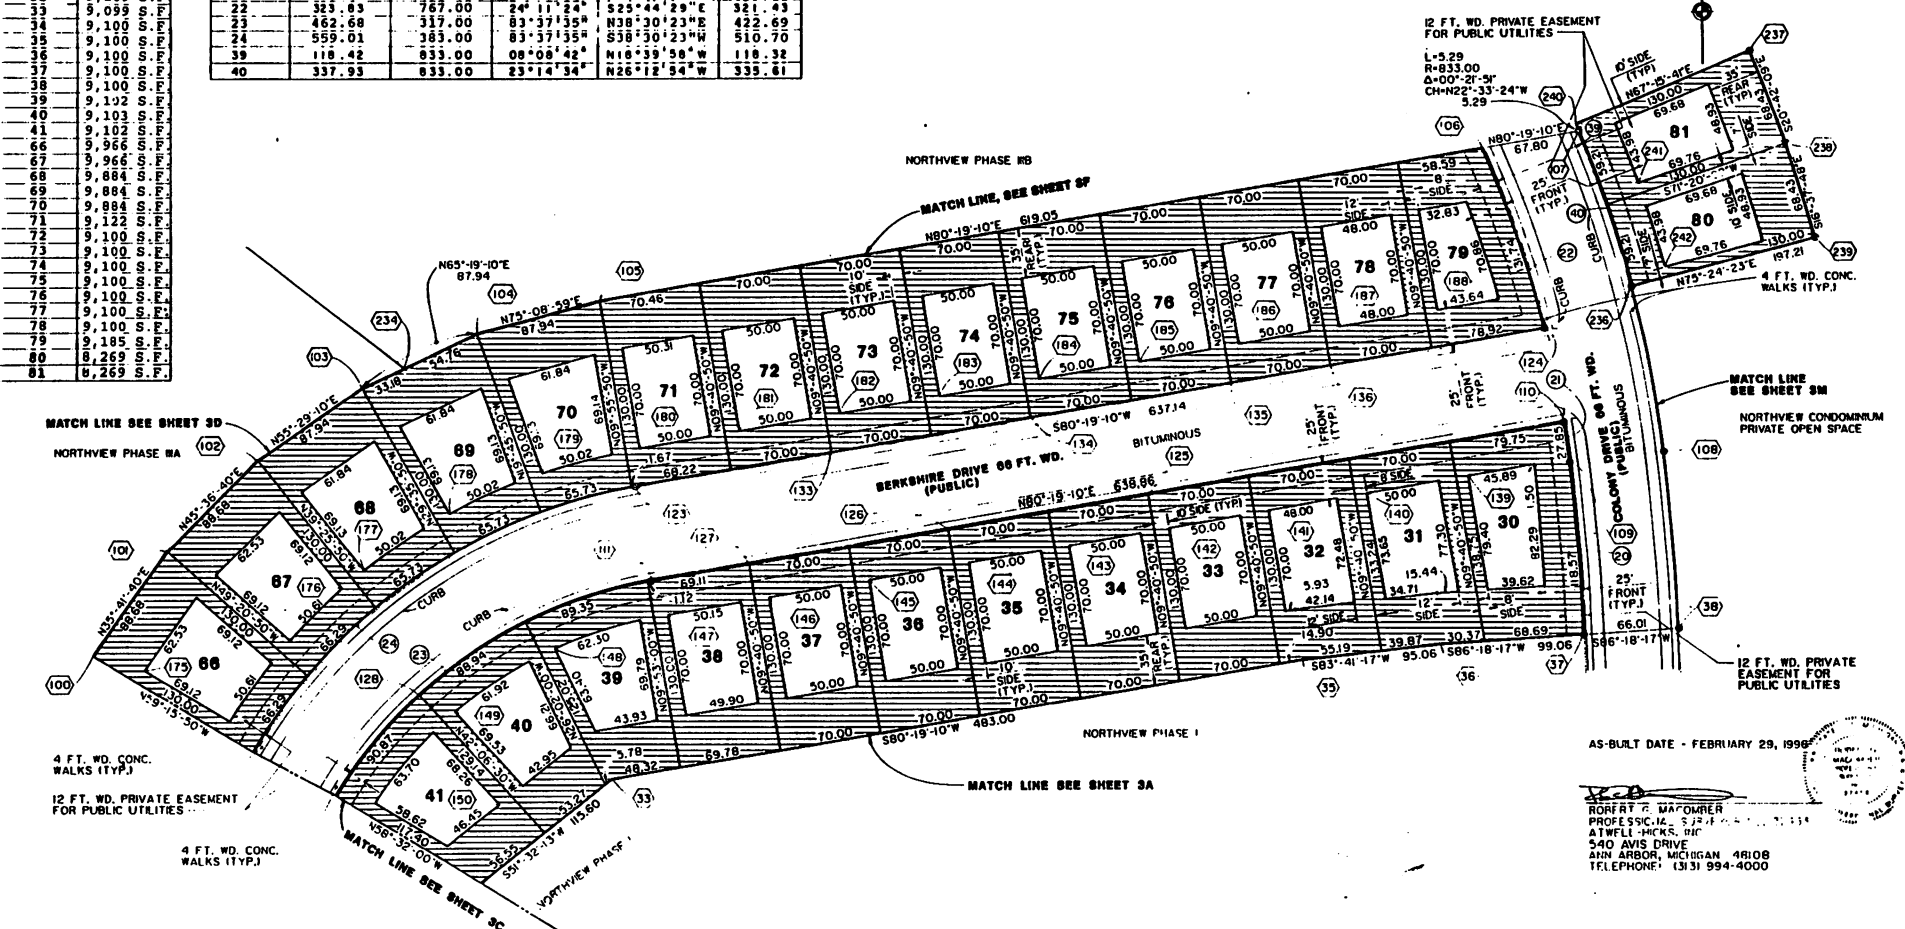

AS-BUILT DATE - FEBRUARY 29, 1998

ROBERT R. MACOMBER
 PROFESSIONAL SURVEYOR
 ATWELL-HICKS, INC.
 540 AVIS DRIVE
 ANN ARBOR, MICHIGAN 48108
 TELEPHONE: (313) 994-4000


SURVEY & SITE PLAN PHASE II (UNITS 30-41 & UNITS 66-81) NORTHVIEW

- LEGEND:**
- (23) INDICATES CURVE NUMBER
 - (126) INDICATES COORDINATE POINT (SEE SHEET 4 FOR LIST)

BEARINGS ARE RELATED TO THE PLAT OF COLONY ESTATES AS RECORDED IN LIBER 21 OF PLATS, PAGES 84-86, WASHTENAW COUNTY RECORDS.

ALL PUBLIC STREET AND UTILITY IMPROVEMENTS HAVE BEEN BUILT

BEARINGS OF THE BUILDING ENVELOPES ARE PARALLEL TO PERIMETER OF UNITS

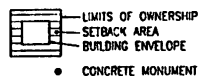

CLIENT: PETER'S BUILDING COMPANY	SECTION 24, TOWN 5 NORTH RANGE 5 EAST	ATWELL-HICKS, INC.	
	CITY OF SALAMIS	CIVIL ENGINEER, SURVEYOR, PLANNER	
	WASHTENAW COUNTY, MICHIGAN	ANN ARBOR	913 994-4000
		DR. JOHN CH. EM.	DATE 2-29-98
		BOOK	FILE NUMBER
	SCALE 1" = 40' FEET	208 76320	198-193B
	SHOWING IN FEET		


COPY
 Page 40 of 67
 Liber 005270 Page 0670

CURVE CHART:

CURVE	ARC LENGTH	RADIUS	DELTA	BEARING	CHORD LENGTH
23	462.68	317.00	83°37'35"	N38°30'23"E	422.69
24	559.04	383.00	81°37'35"	S38°30'23"W	510.70
25	410.65	283.00	83°08'25"	N38°15'48"E	375.56
26	314.88	217.00	83°08'25"	S38°15'48"W	287.98
27	471.54	283.00	77°22'31"	S42°25'58"E	418.86
28	361.57	217.00	95°29'03"	S32°25'58"E	321.7
29	8.80	1533.00	00°19'44"	N00°13'03"W	8.80
30	145.58	717.00	11°38'01"	S06°11'56"E	145.33
31	156.86	783.00	11°28'40"	N06°07'15"W	156.59

AREA CHART:

UNIT	AREA
42	9,101 S.F.
43	9,237 S.F.
44	9,488 S.F.
45	11,520 S.F.
46	14,382 S.F.
47	19,119 S.F.
48	25,345 S.F.
49	21,293 S.F.
50	16,839 S.F.
51	14,199 S.F.
52	9,178 S.F.
53	9,512 S.F.
54	12,258 S.F.
55	20,867 S.F.
56	8,219 S.F.
57	7,716 S.F.
58	8,381 S.F.
59	10,958 S.F.
60	9,320 S.F.
61	9,164 S.F.
62	9,108 S.F.
63	9,966 S.F.
64	9,966 S.F.
65	9,966 S.F.
252	19,697 S.F.

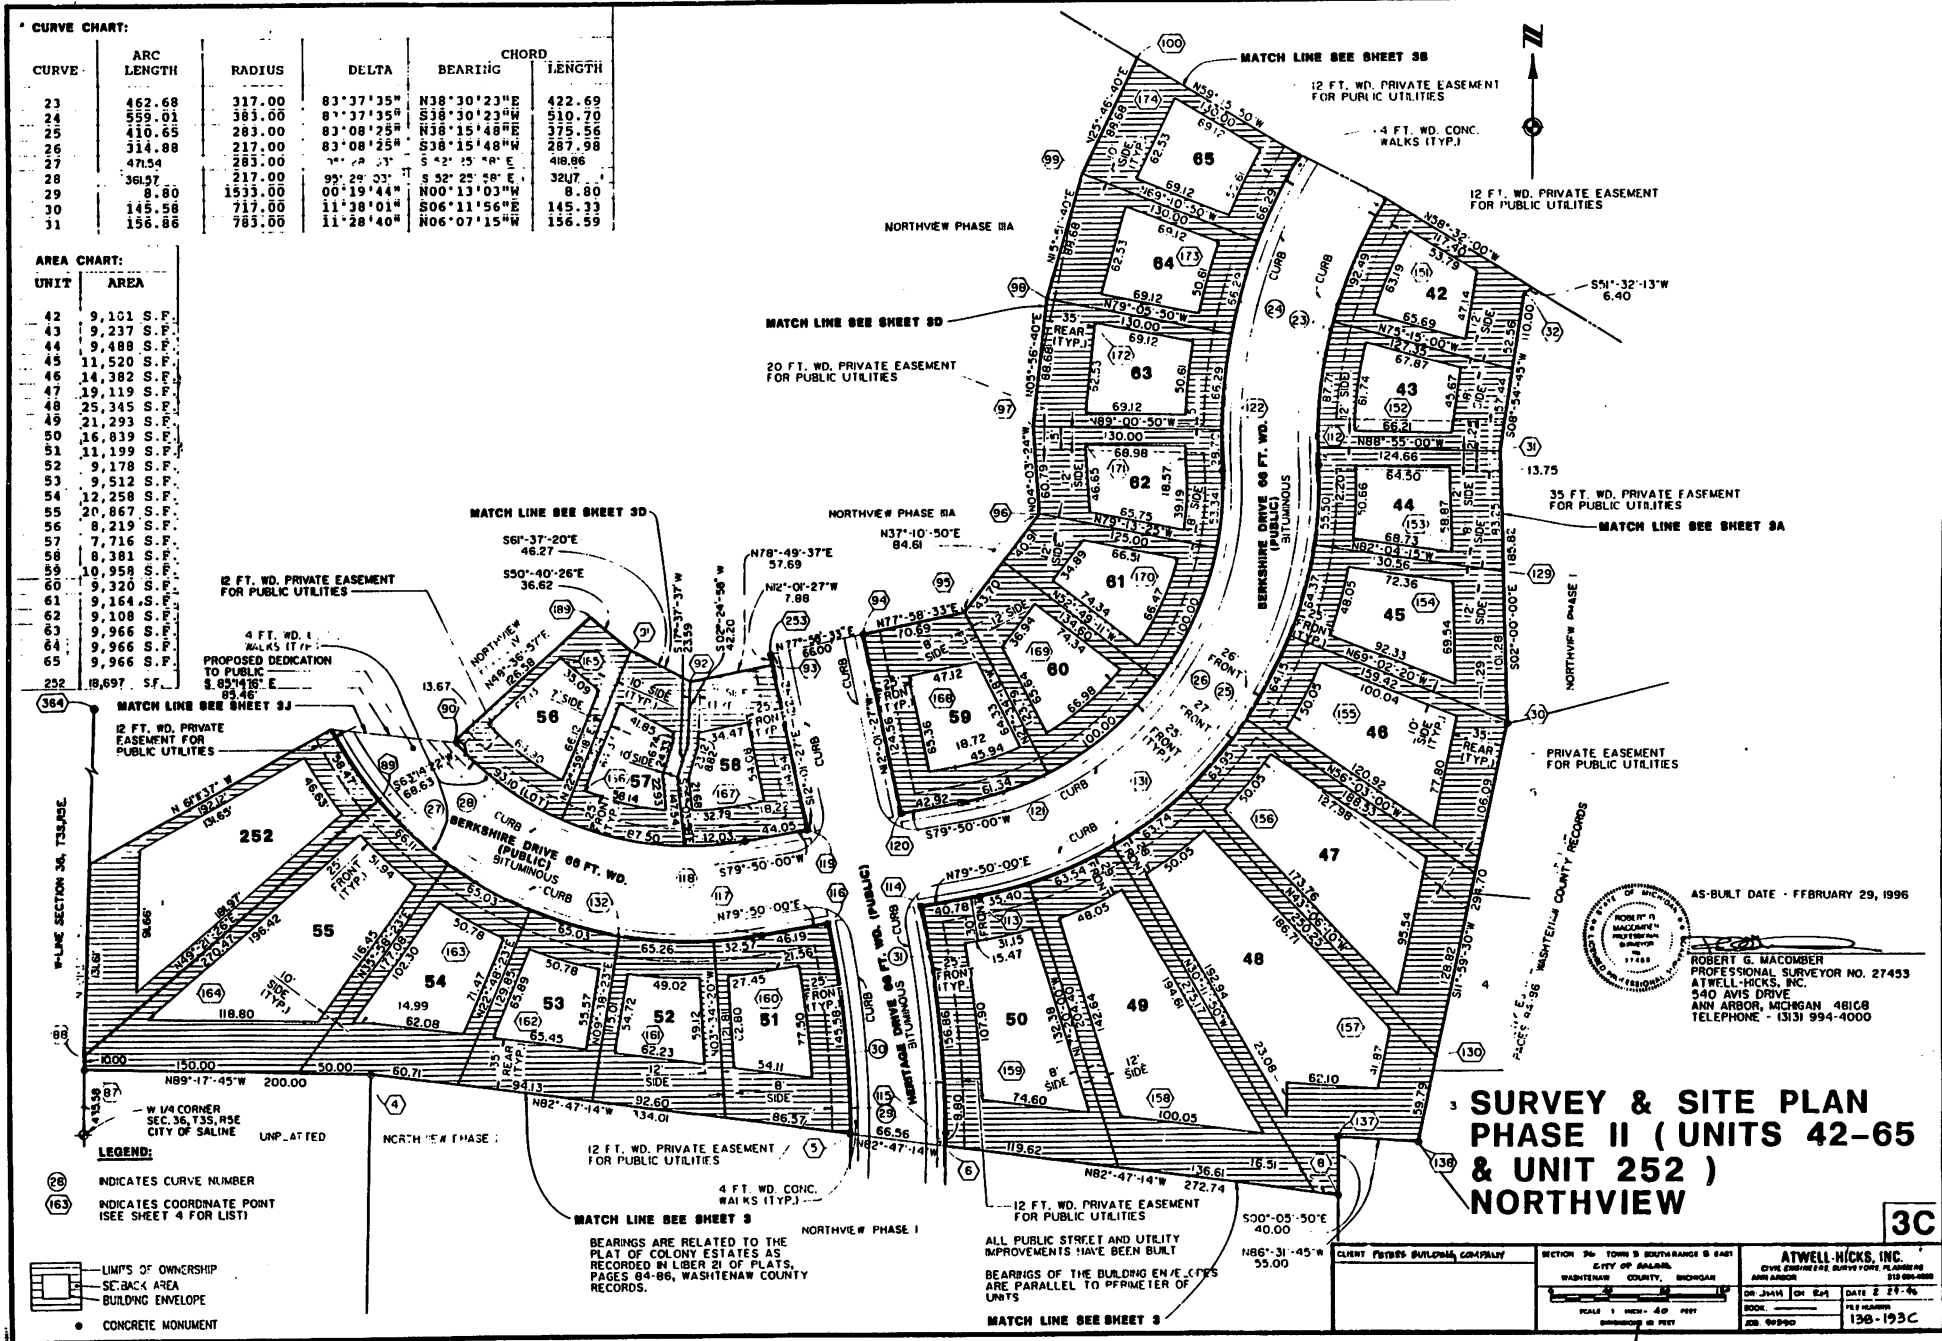

**3 SURVEY & SITE PLAN
PHASE II (UNITS 42-65
& UNIT 252)
NORTHVIEW**

3C



AS-BUILT DATE - FEBRUARY 29, 1996
 ROBERT G. MACOMBER
 PROFESSIONAL SURVEYOR NO. 27453
 ATWELL-HICKS, INC.
 540 AVIS DRIVE
 ANN ARBOR, MICHIGAN 48106
 TELEPHONE - (313) 994-4000

- LEGEND:**
- (28) INDICATES CURVE NUMBER
 - (163) INDICATES COORDINATE POINT (SEE SHEET 4 FOR LIST)
 - LIMPUS OF OWNERSHIP
 - SE BACK AREA
 - BUILDING ENVELOPE
 - CONCRETE MONUMENT

BEARINGS ARE RELATED TO THE PLAT OF COLONY ESTATES AS RECORDED IN LIBER 21 OF PLATS, PAGES 84-86, WASHTENAW COUNTY RECORDS.

ALL PUBLIC STREET AND UTILITY IMPROVEMENTS HAVE BEEN BUILT. BEARINGS OF THE BUILDING ENVELOPES ARE PARALLEL TO PERIMETER OF UNITS.


CLIENT: PETER'S BUILDING COMPANY	SECTION: 36, TOWN 9, BOUNDARY & EAST	ATWELL-HICKS, INC.
	CITY OF SALINE	CIVIL ENGINEER, SURVEYING, PLANNING
	WASHTENAW COUNTY, MICHIGAN	AND ARCHITECT 310 000-0000
	DR. JAMES OH EAS	DATE: 2-27-96
	SCALE: 1" = 40' FEET	PET. RECORDS
	ENHANCING IN FEET	JOB: 99990
		130-193C

LIBER 05220 PAGE 0071
 PAGE 4 OF 67
 COPY



CURVE	ARC LENGTH	RADIUS	DELTA	CHORD	
				BEARING	LENGTH
32	113.34	503.00	11°08'18"	S 83°00'26" E	113.16
33	166.78	342.00	27°56'13"	S 34°19'33" W	165.11
34	745.40	709.00	60°18'06"	S 18°08'06" W	712.41
35	876.92	643.00	60°18'06"	N 18°08'06" E	846.09
36	65.08	583.00	06°28'37"	S 71°49'24" E	66.04
39	201.45	408.00	28°17'23"	S 34°08'57" W	199.41

UNIT	AREA
82	9,605 S.F.
83	7,931 S.F.
84	8,034 S.F.
85	7,989 S.F.
86	7,903 S.F.
87	7,903 S.F.
88	7,903 S.F.
89	7,903 S.F.
90	7,903 S.F.
91	7,903 S.F.
92	7,903 S.F.
93	7,903 S.F.
94	8,159 S.F.
95	7,919 S.F.
96	12,204 S.F.
97	8,156 S.F.
98	8,184 S.F.
99	8,180 S.F.
100	8,159 S.F.
101	8,196 S.F.
102	8,165 S.F.
103	8,168 S.F.
104	8,081 S.F.
105	8,186 S.F.
106	9,853 S.F.

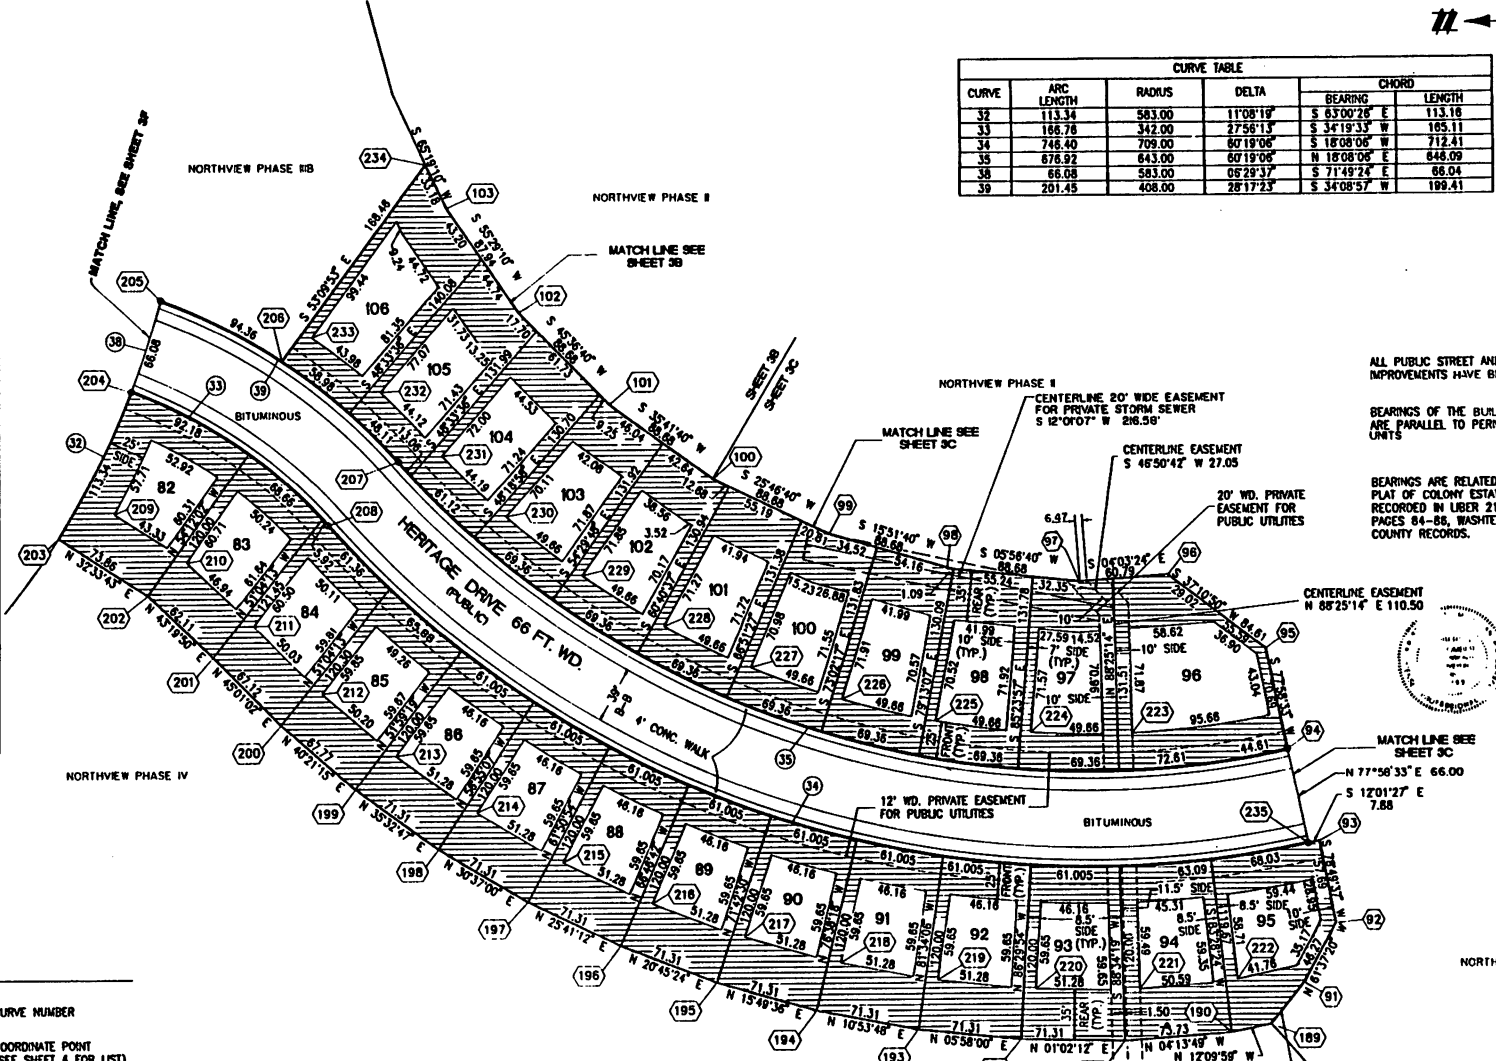

ALL PUBLIC STREET AND UTILITY IMPROVEMENTS HAVE BEEN BUILT

BEARINGS OF THE BUILDING ENVELOPES ARE PARALLEL TO PERIMETER OF UNITS

BEARINGS ARE RELATED TO THE PLAT OF COLONY ESTATES AS RECORDED IN LIBER 21 OF PLATS, PAGES 84-86, WASHTENAW COUNTY RECORDS.



AS-BUILT DATE - FEBRUARY 29, 1996

LEGEND:

- (18) CURVE NUMBER
- (265) COORDINATE POINT (SEE SHEET 4 FOR LIST)
- [Symbol] LIMITS OF OWNERSHIP
- [Symbol] SETBACK AREA
- [Symbol] BUILDING ENVELOPE
- CONCRETE MONUMENT

**SURVEY AND SITE PLAN
PHASE 3A (UNITS 82-106)
NORTHVIEW**

3D

CLIENT: PETERS BUILDING COMPANY	SECTION 36 TOWN 3 SOUTH RANGE 9 EAST	ATWELL-HICKS, INC.
	CITY OF SALINE WASHTENAW COUNTY, MICHIGAN	CIVIL ENGINEER, CONVEYOR, PLANNING ANN ARBOR (313) 994-4000
	DATE: 2-29-96	138-193D
	SCALE: 1" = 40' OR AS NOTED	
	MEASURED IN FEET	

LIBER 03320 Page 0672
PAGE 42 OF 67
COPY

UNIT	AREA
139	8.003 S.F.
140	7.930 S.F.
141	7.930 S.F.
142	10.075 S.F.
143	9.889 S.F.
144	8.281 S.F.
145	9.235 S.F.
146	8.348 S.F.
147	14.671 S.F.
148	11.663 S.F.
149	9.573 S.F.
150	16.325 S.F.
151	12.325 S.F.
152	10.714 S.F.
153	14.479 S.F.
154	14.713 S.F.
155	13.583 S.F.
156	14.999 S.F.

CURVE	ARC LENGTH	RADIUS	DELTA	CHORD	
				BEARING	LENGTH
40	21.43	378.91	03°14'23"	S 00°02'12" E	21.42
41	246.96	378.91	37°20'37"	S 20°19'42" E	242.61
42	153.19	444.91	19°43'40"	S 08°18'53" E	152.41
43	315.13	444.91	40°34'59"	S 18°42'31" E	308.59
44	276.44	65.00	24°34'02"	N 07°09'47" W	110.44
45	55.57	50.00	63°40'26"	S 82°50'13" W	52.75
64	268.38	378.91	40°34'56"	S 18°42'30" E	262.81

NOTES:

ALL PUBLIC STREET AND UTILITY IMPROVEMENTS HAVE BEEN BUILT

BEARINGS ARE RELATED TO THE PLAN OF COLONY ESTATES AS RECORDED IN LIBER 21 OF PLATS, PAGES 84-86, WASHTENAW COUNTY RECORDS

BEARINGS OF THE BUILDING ENVELOPES ARE PARALLEL TO PERIMETER OF UNITS

LEGEND:



- 44 INDICATES CURVE NUMBER
- 270 INDICATES COORDINATE POINT (SEE SHEET 4 FOR LIST)

- LIMITS OF OWNERSHIP
SETBACK AREA
BUILDING ENVELOPE
- CONCRETE MONUMENT

AS-BUILT DATE - FEBRUARY 29, 1996



ROBERT C. MACOMBER
PROFESSIONAL SURVEYOR NO. 27453
ATWELL-HICKS, INC.
540 AVIS DRIVE
ANN ARBOR, MICHIGAN 48108
TELEPHONE - (313) 994-4000

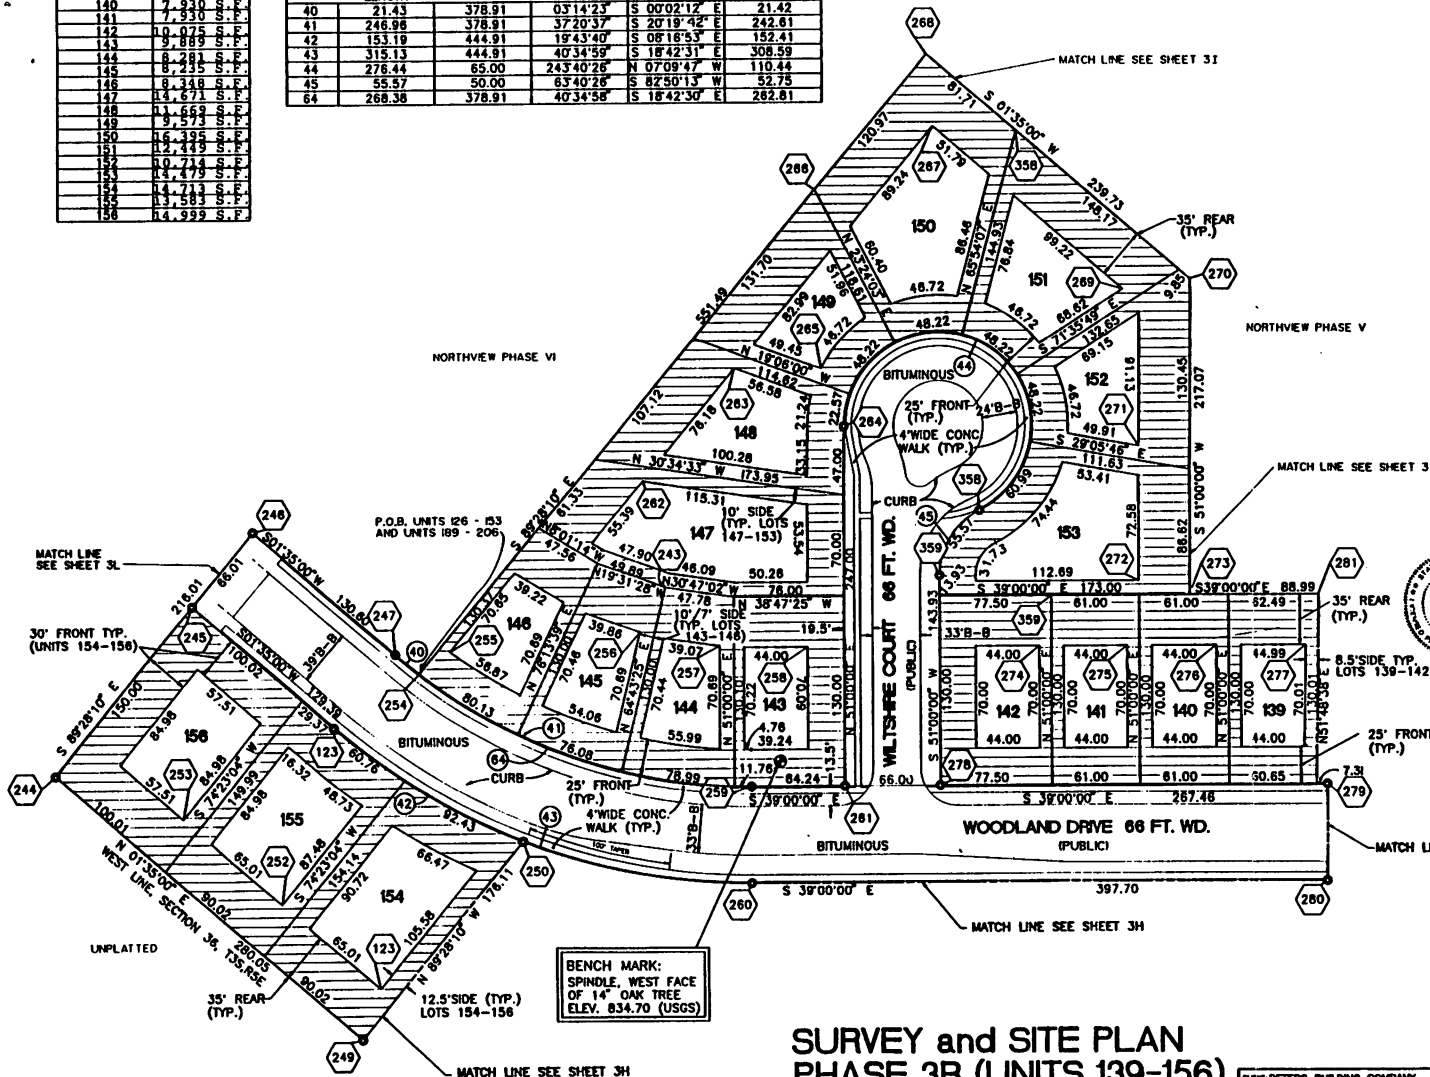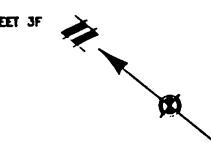

**SURVEY and SITE PLAN
PHASE 3B (UNITS 139-156)
NORTHVIEW**

OWNER: PETERS BUILDING COMPANY

SECTION 36 TOWN 3 SOUTH, RANGE 9 EAST
CITY OF SALINE
WASHTENAW COUNTY, MICHIGAN

ATWELL-HICKS, INC.
CIVIL ENGINEERS, SURVEYORS, PLANNERS
ANN ARBOR (313) 994-4000

DATE: 2-29-96

DATE: 2-29-96

SCALE: 1" = 40' FEET

SCALE: 1" = 40' FEET

BOOK: 138-193E

BOOK: 138-193E

3E

copy
PAGE 43 OF 67

LIBER 23820 PAGE 0813

UNIT	AREA
107	11,168 S.F.
108	10,415 S.F.
109	9,941 S.F.
110	8,929 S.F.
111	8,120 S.F.
112	8,097 S.F.
113	8,120 S.F.
114	7,846 S.F.
115	9,517 S.F.
116	9,815 S.F.
117	8,880 S.F.
118	8,880 S.F.
119	10,141 S.F.
120	10,056 S.F.
121	7,230 S.F.
122	7,821 S.F.
123	7,821 S.F.
124	7,821 S.F.
125	7,821 S.F.
126	7,821 S.F.
127	7,821 S.F.
128	7,983 S.F.


CURVE	ARC LENGTH	RADIUS	DELTA	CHORD	
				BEARING	LENGTH
38	88.08	583.00	05°29'37"	S 71°48'24" E	86.04
39	201.45	408.00	28°17'23"	S 34°08'57" W	199.41
46	300.85	583.00	29°34'35"	S 53°47'18" E	297.62
47	545.77	517.00	60°29'04"	S 69°14'32" E	520.78
48	248.42	583.00	24°24'51"	S 87°18'38" E	246.55
49	28.25	197.00	08°13'01"	N 13°35'34" W	28.23
50	28.21	263.00	08°08'44"	N 12°33'26" W	28.20
51	182.47	328.33	28°21'07"	N 66°20'22" E	180.82
52	185.13	394.33	28°21'07"	N 66°20'22" E	183.14



LEGEND:

- Ⓢ INDICATES CURVE NUMBER
- Ⓢ INDICATES COORDINATE POINT (SEE SHEET 4 FOR LIST)

- LIMITS OF OWNERSHIP
SETBACK AREA
BUILDING ENVELOPE
- CONCRETE MONUMENT

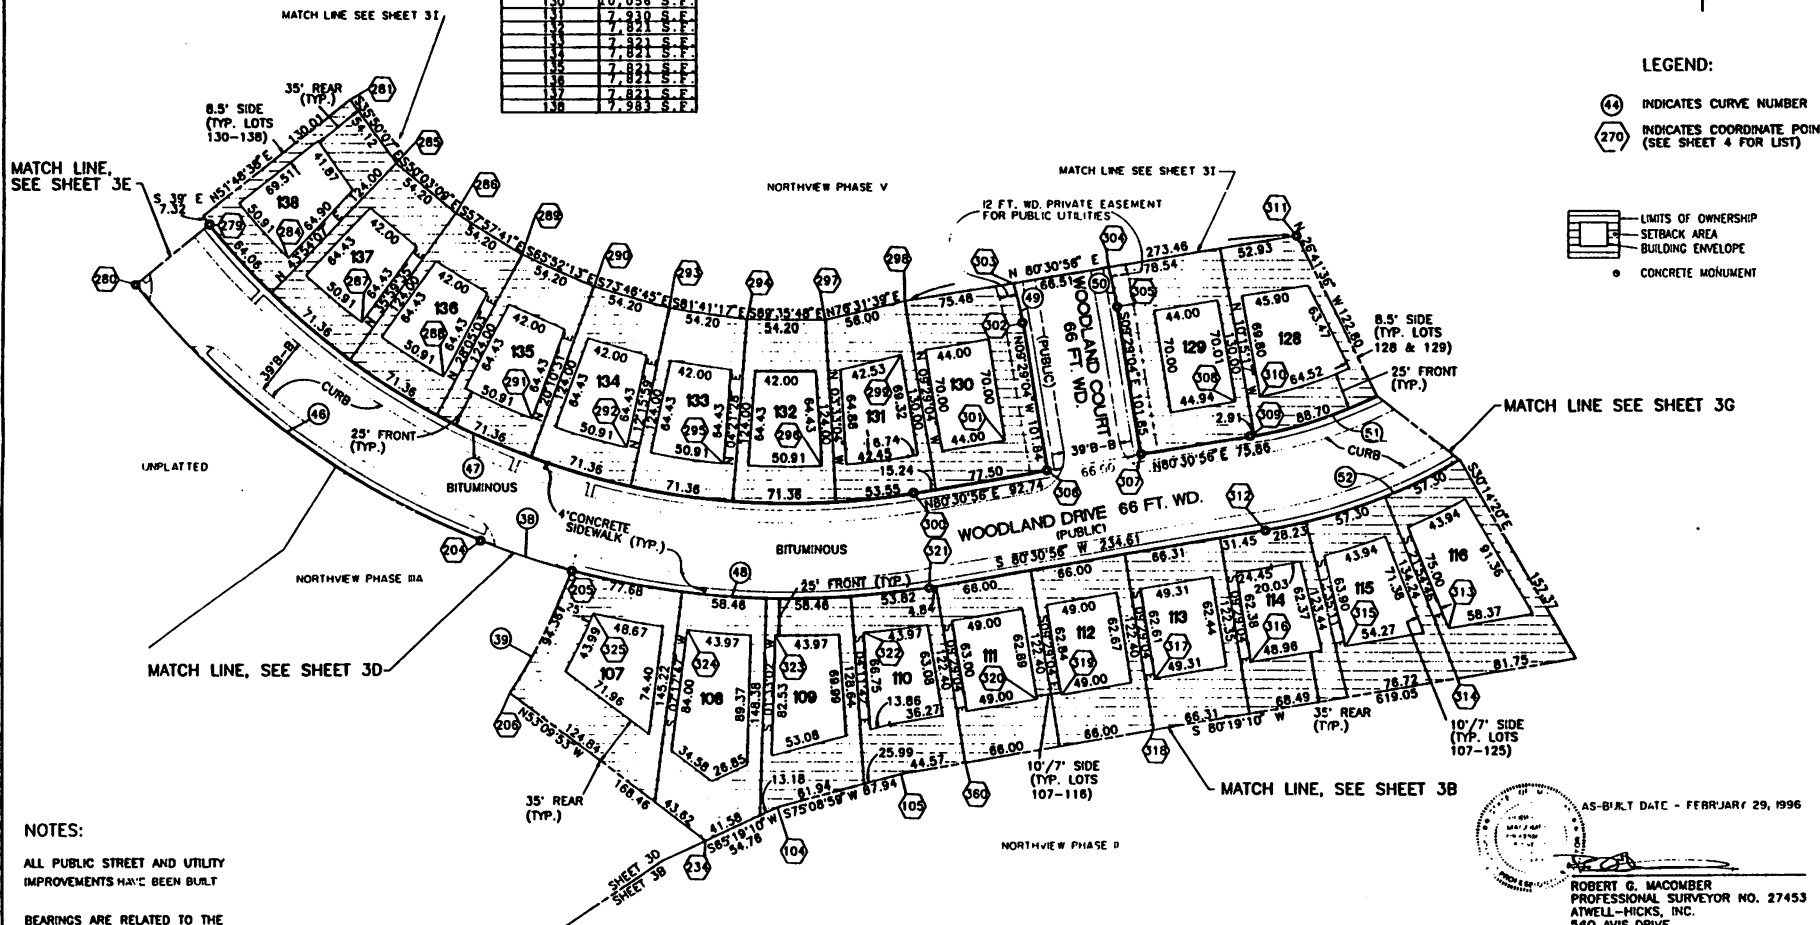

NOTES:

ALL PUBLIC STREET AND UTILITY IMPROVEMENTS HAVE BEEN BUILT

BEARINGS ARE RELATED TO THE PLAT OF COLONY ESTATES AS RECORDED IN LIBER 21 OF PLATS, PAGES 84-88, WASHTENAW COUNTY RECORDS

BEARINGS OF THE BUILDING ENVELOPES ARE PARALLEL TO PERIMETER OF UNITS

**SURVEY and SITE PLAN
PHASE 3B (UNITS 107-116
and 128-138)
NORTHVIEW**

AS-BUILT DATE - FEBRUARY 29, 1996


ROBERT G. MACOMBER
PROFESSIONAL SURVEYOR NO. 27453
ATWELL-HICKS, INC.
540 AVIS DRIVE
ANN ARBOR, MICHIGAN 48108
TELEPHONE - (313) 994-4000

3F

CLIENT: PETERS BUILDING COMPANY	SECTION 36 TOWN 3 SOUTH, RANGE 3 EAST CITY OF SALEM WASHTENAW COUNTY, MICHIGAN	ATWELL-HICKS, INC. CIVIL ENGINEERS, SURVEYORS, PLANNERS AND ARCHITECTS EST. 1944
DATE: 7-7-96	SCALE: 1" = 40' FEET AS SHOWN ON THIS PLAN	DATE: 7-7-96
NO. 138-193F	NO. 80390.31	138-193F

LIBER 00320 Page 0014
PAGE 44 OF 67
COPY

€ 100 FT. WD. EASEMENT FOR PITTSFIELD HOI DRAIN PER LIBER 609 PAGE 21 WASHTEANW COUNTY RECORDS

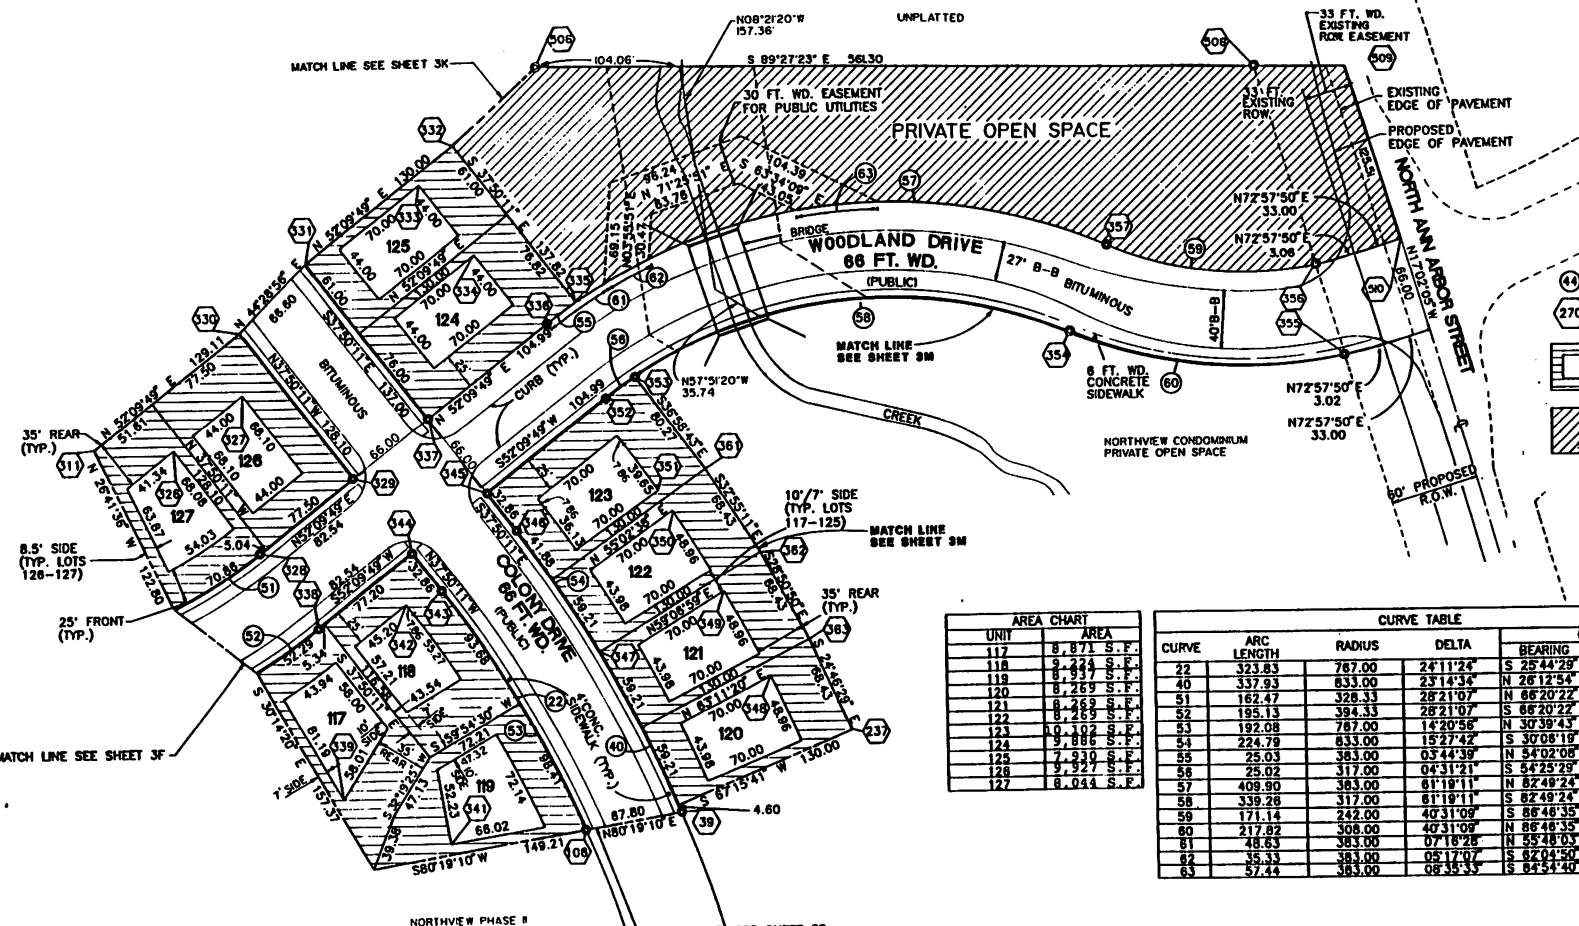

- LEGEND:**
- (40) INDICATES CURVE NUMBER
 - (270) INDICATES COORDINATE POINT (SEE SHEET 4 FOR LIST)
 - [Symbol] LIMITS OF OWNERSHIP
 - [Symbol] SETBACK AREA
 - [Symbol] BUILDING ENVELOPE
 - [Symbol] GENERAL COMMON ELEMENT
 - CONCRETE MONUMENT

AREA CHART

UNIT	AREA
117	8.871 S.F.
118	9.221 S.F.
119	8.994 S.F.
120	8.269 S.F.
121	8.269 S.F.
122	8.269 S.F.
123	8.010 S.F.
124	9.886 S.F.
125	7.930 S.F.
126	9.927 S.F.
127	8.044 S.F.

CURVE TABLE

CURVE	ARC LENGTH	RADIUS	DELTA	CHORD	
				BEARING	LENGTH
22	323.83	787.00	24°11'24"	S 25°44'28" E	321.43
40	337.93	833.00	23°14'34"	N 28°12'54" W	335.81
51	162.47	328.33	28°21'07"	N 66°20'22" E	160.82
52	195.13	394.33	28°21'07"	S 66°20'22" W	193.14
53	192.08	787.00	14°20'58"	N 30°09'43" W	191.58
54	224.79	833.00	15°27'42"	S 30°09'18" E	224.11
55	25.03	383.00	03°44'39"	N 54°02'08" E	25.02
56	25.02	317.00	04°31'21"	S 54°25'28" W	25.01
57	409.90	383.00	61°19'11"	N 82°49'24" E	390.81
58	339.28	317.00	61°19'11"	S 82°49'24" W	323.30
59	171.14	242.00	40°31'09"	S 86°48'35" E	167.80
60	217.82	308.00	40°31'09"	N 86°48'35" W	213.31
61	48.63	383.00	07°19'28"	N 39°48'03" E	48.59
62	35.33	383.00	05°17'07"	S 62°04'50" W	35.32
63	57.44	363.00	08°16'33"	S 84°31'40" W	57.38

NOTES:

ALL PUBLIC STREET AND UTILITY IMPROVEMENTS HAVE BEEN BUILT

BEARINGS ARE RELATED TO THE PLAT OF COLONY ESTATES AS RECORDED IN LIBER 21 OF PLATS, PAGES 84-88, WASHTEANW COUNTY RECORDS

BEARINGS OF THE BUILDING ENVELOPES ARE PARALLEL TO PERIMETER OF UNITS

**SURVEY and SITE PLAN
PHASE 3B (UNITS 117-127)
NORTHVIEW**

AS-BUILT DATE - FEBRUARY 29, 1996

ROBERT G. MACOMBER
PROFESSIONAL SURVEYOR NO. 27453
ATWELL-HICKS, INC.
940 AVIS DRIVE
ANN ARBOR, MICHIGAN 48108
TELEPHONE - (313) 994-4000



3G

CLIENT: PETERS BUILDING COMPANY	SECTION 38 TOWN 3 SOUTH, RANGE 3 EAST CITY OF SALINE WASHTEANW COUNTY, MICHIGAN	ATWELL-HICKS, INC. CIVIL ENGINEERS, SURVEYORS, PLANNERS AND ARCHITECTS DATE: 2-29-96 SHEET NO. 138-193G
---------------------------------	---	---




copy
Page 45 of 67

NOTES:

ALL PUBLIC STREET AND UTILITY IMPROVEMENTS HAVE BEEN B'ALT.

BEARINGS ARE RELATED TO THE PLAT OF COLONY ESTATES AS RECORDED IN LIBER 21 OF PLATS, PAGES 84-86, WASHTENAW COUNTY RECORDS

LEGEND:

-  INDICATES COORDINATE POINT (SEE SHEET 4 FOR LIST)
-  INDICATES GENERAL COMMON ELEMENT
-  INDICATES CONCRETE MONUMENT


MATCH LINE, SEE SHEET 3E

MATCH LINE, SEE SHEET 3E

MATCH LINE, SEE SHEET 3E

MATCH LINE, SEE SHEET 3J

UNPLATTED

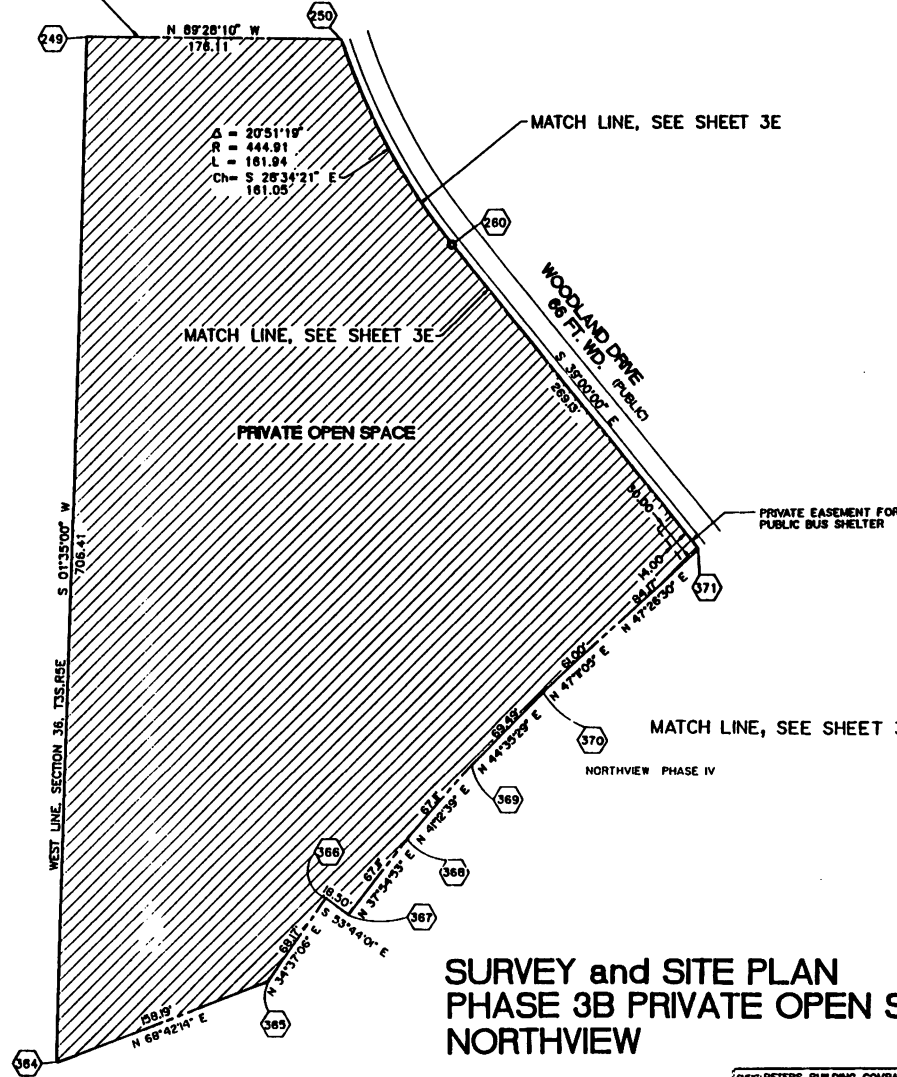

AS-BUILT DATE - FEBRUARY 29, 1998

ROBERT G. MACOMBER
PROFESSIONAL SURVEYOR NO. 27453
ATWELL-HICKS, INC.
540 AVIS DRIVE
ANN ARBOR, MICHIGAN 48108
TELEPHONE - (313) 994-4000

**SURVEY and SITE PLAN
PHASE 3B PRIVATE OPEN SPACE
NORTHVIEW**


3H

CLIENT: PETERS BUILDING COMPANY	SECTION: 36 TOWNSHIP 3 SOUTH, RANGE 5 EAST CITY OF SALINE WASHTENAW COUNTY, MICHIGAN	ATWELL-HICKS, INC. CIVIL ENGINEERS, SURVEYORS, PLANNERS ANN ARBOR (313) 994-4000
	DATE: 2-24-98 BY: [Signature]	REV. NO. 138-193H
SCALE: 1" = 40' HORIZONTAL 1" = 20' VERTICAL	BOOK: 80380.31	

LIBER 00070 Page 06/15
PAGE 46 OF 67
COPY

CURVE DATA					
CURVE	RADIUS	LENGTH	CHORD	BEARING	DELTA
64	197.00	79.74	79.19	N 29°17'45" W	23°11'25"
65	367.55	107.39	107.01	N 17°31'10" W	19°11'10"
66	65.00	19.84	19.84	N 19°50'15" W	23°40'28"
67	50.00	55.57	52.75	S 77°09'47" E	83°40'28"
68	50.00	38.22	37.50	N 40°54'05" W	43°48'08"
69	65.00	303.59	63.83	N 71°00'00" E	287°38'13"
70	50.00	38.22	37.50	S 62°54'05" W	43°48'08"
71	301.55	115.22	114.82	S 29°58'45" E	21°53'33"
72	283.00	115.88	115.02	S 28°19'40" E	25°19'44"

AREA CHART	
UNIT	AREA
189	10,527 SF
190	10,241 SF
191	12,408 SF
192	11,854 SF
193	12,078 SF
194	14,142 SF
195	10,410 SF
196	15,602 SF
197	11,898 SF
198	17,863 SF
199	11,531 SF
200	9,498 SF
201	9,287 SF
202	9,527 SF
203	9,139 SF
204	9,267 SF
205	9,180 SF
206	10,019 SF

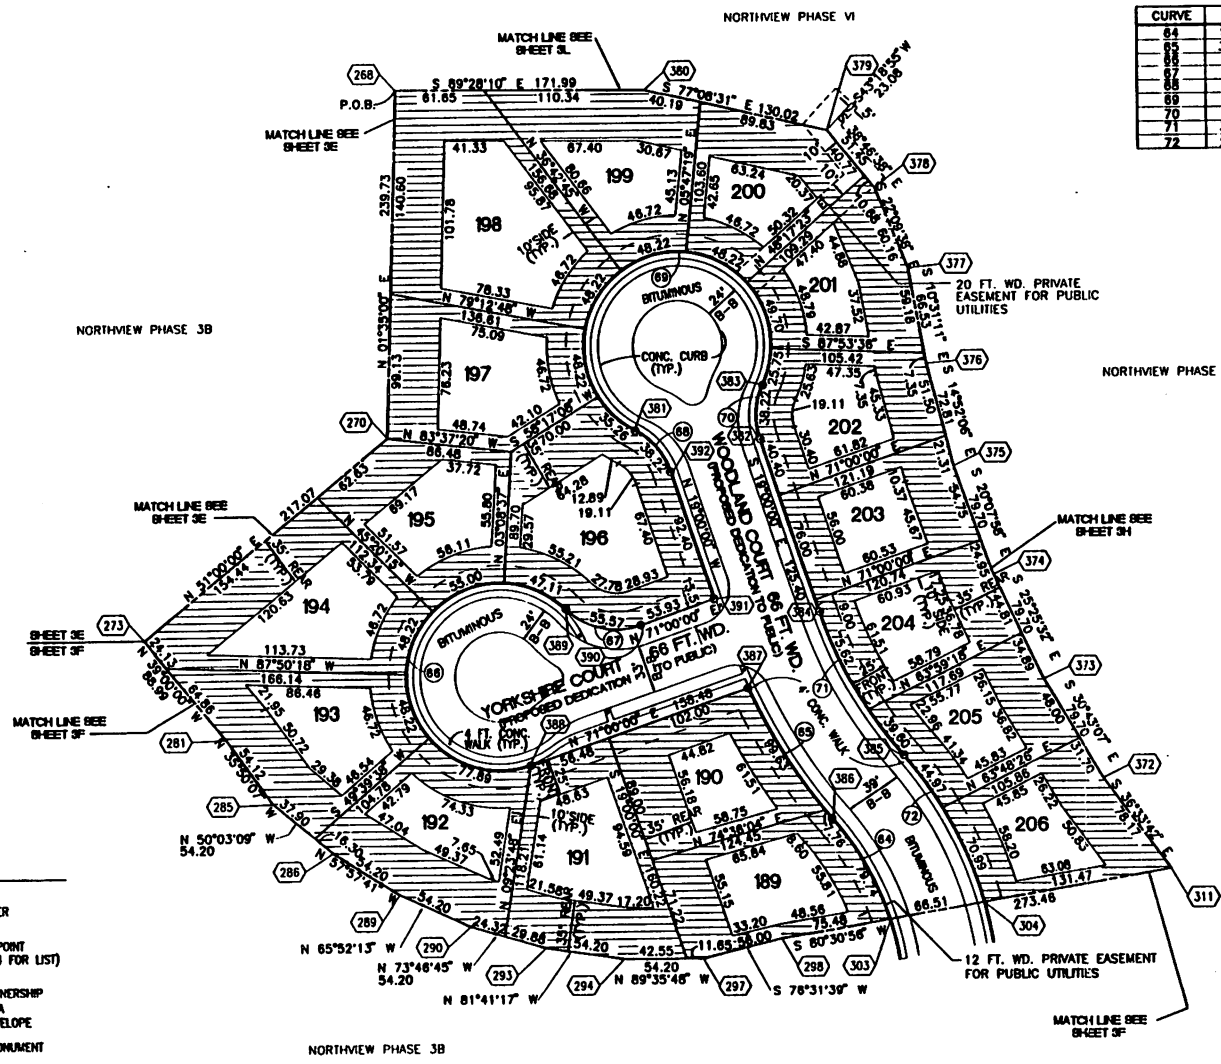

ALL PUBLIC STREET AND UTILITY IMPROVEMENTS HAVE BEEN BUILT

BEARINGS OF THE BUILDING ENVELOPES ARE PARALLEL TO PERIMETER OF UNITS

BEARINGS ARE RELATED TO THE PLAT OF COLONY ESTATES AS RECORDED IN LIBER 21 OF PLATS, PAGES 64-66, WASHINGTON COUNTY RECORDS.



AS BUILT DATE - FEBRUARY 28, 1998

Bruce C. Wallace

BRUCE C. WALLACE
LICENSED PROFESSIONAL ENGINEER NO. 39722
ATWELL-HICKS, INC.
540 AVIS DRIVE
ANN ARBOR, MICHIGAN 48108
TELEPHONE - (313) 994-4000

SURVEY AND SITE PLAN PHASE 5 (UNITS 189-206) NORTHVIEW

3I

CLIENT: PETERS BUILDING COMPANY	SECTION 36 TOWN 3 SOUTH, RANGE 3 EAST	ATWELL-HICKS, INC. CIVIL ENGINEERS, SURVEYORS, PLANNERS ANN ARBOR (313) 994-4000
CITY OF SALINE	WASHINGTON COUNTY, MICHIGAN	DATE: 2/29/1998
SCALE: 1" = 40' FEET	BOOK: _____	PLAT NO: 138-193

LIBER 03020 Page 0617

COPY

PAGE 47 OF 67

NORTHVIEW CONDOMINIUM
PHASE 3B

NORTHVIEW CONDOMINIUM
PHASE 3A

NORTHVIEW CONDOMINIUM
PHASE 3A

NORTHVIEW CONDOMINIUM
PARK AREA
PHASE 3B

NORTHVIEW CONDOMINIUM
PHASE 2

- LEGEND:
- (18) CURVE NUMBER
 - (285) COORDINATE POINT (SEE SHEET 4 FOR LIST)
 - [Symbol] LIMITS OF OWNERSHIP
 - [Symbol] SETBACK AREA
 - [Symbol] BUILDING ENVELOPE
 - [Symbol] CONCRETE MONUMENT

ALL PUBLIC STREET AND UTILITY
IMPROVEMENTS HAVE BEEN BUILT

BEARINGS OF THE BUILDING ENVELOPES
ARE PARALLEL TO PERIMETER OF
UNITS

BEARINGS ARE RELATED TO THE
PLAY OF COLONY ESTATES AS
RECORDED IN LIBER 21 OF PLATS,
PAGES 84-86, WASHTEWAW
COUNTY RECORDS.

AREA CHART

UNIT	AREA
157	10,676 S.F.
158	9,456 S.F.
159	8,620 S.F.
160	8,823 S.F.
161	8,830 S.F.
162	8,824 S.F.
163	8,621 S.F.
164	8,622 S.F.
165	8,627 S.F.
166	8,629 S.F.
167	8,623 S.F.
168	8,621 S.F.
169	8,623 S.F.
170	8,628 S.F.
171	10,465 S.F.
172	9,645 S.F.
173	10,531 S.F.
174	8,015 S.F.
175	8,423 S.F.
176	8,307 S.F.
177	8,307 S.F.
178	9,556 S.F.
179	11,817 S.F.
180	16,024 S.F.
181	15,191 S.F.
182	13,044 S.F.
183	11,347 S.F.
184	10,041 S.F.
185	9,098 S.F.
186	8,452 S.F.
187	8,120 S.F.
249	8,080 S.F.
250	8,360 S.F.
251	10,024 S.F.
251	12,793 S.F.

CURVE DATA

CURVE	RADIUS	LENGTH	CHORD	BEARING	DELTA
48	503.00	118.39	118.10	S81°37'17"E	11°38'07"
73	908.13	881.94	851.82	S21°22'16"W	52°08'26"
74	1035.13	942.00	909.83	N21°22'17"E	52°08'57"
75	583.00	3.18	3.18	S39°09'23"E	00°18'46"
76	593.00	68.94	68.00	S42°33'26"E	06°29'23"
77	217.00	361.57	321.17	S52°25'58"E	85°26'03"
78	283.00	471.35	418.66	S52°25'58"E	85°26'03"



AS-BUILT DATE - FEBRUARY 29, 1996
Bruce C. Wallace
 BRUCE C. WALLACE
 LICENSED PROFESSIONAL ENGINEER NO. 39723
 ATWELL-HICKS, INC.
 840 AHS DRIVE
 ANN ARBOR, MICHIGAN 48108
 TELEPHONE - (313) 994-4000

**SURVEY AND SITE PLAN
 PHASE 4 (UNITS 157-188 AND UNITS 249-251)
 NORTHVIEW**

CLIENT: PETERS BUILDING COMPANY	SECTION 36 TOWNSHIP 3 SOUTH, RANGE 9 EAST CITY OF SALINE WASHTENAW COUNTY, MICHIGAN	ATWELL-HICKS, INC. ONE COLUMBIA, SALINE, MICHIGAN (313) 994-4000
DATE: 02/29/96	SCALE: 1" = 40' ±	DATE: 02/29/96
BY: [Signature]	PROJECT NO: 136-193J	

LIBER 055270 PAGE 0678
 PAGE 48 OF 67
 COPY

CURVE CHART

CURVE	RADIUS	LENGTH	CHORD	BEARING	DELTA
79	733.00	389.27	385.37	N23°24'16"W	28°51'51"
80	317.00	445.37	409.63	N49°13'15"W	80°29'50"
81	383.00	538.09	494.92	S49°13'15"E	80°29'50"
82	667.00	336.02	332.48	S23°24'16"E	28°51'51"

UNIT	AREA
207	9,430
208	9,515
209	9,515
210	9,515
211	9,515
212	9,102
213	9,028
214	9,110
215	9,110

LEGEND:

- (18) CURVE NUMBER
- (285) COORDINATE POINT (SEE SHEET 4 FOR LIST)
- [Symbol] LIMITS OF OWNERSHIP
- [Symbol] SETBACK AREA
- [Symbol] BUILDING ENVELOPE
- [Symbol] GENERAL COMMON ELEMENT
- CONCRETE MONUMENT

ALL PUBLIC STREET AND UTILITY IMPROVEMENTS HAVE BEEN BUILT

BEARINGS OF THE BUILDING ENVELOPES ARE PARALLEL TO PERMETER OF UNITS

BEARINGS ARE RELATED TO THE PLAT OF COLONY ESTATES AS RECORDED IN LIBER 21 OF PLATS, PAGES 64-66, WASHTENAW COUNTY RECORDS.

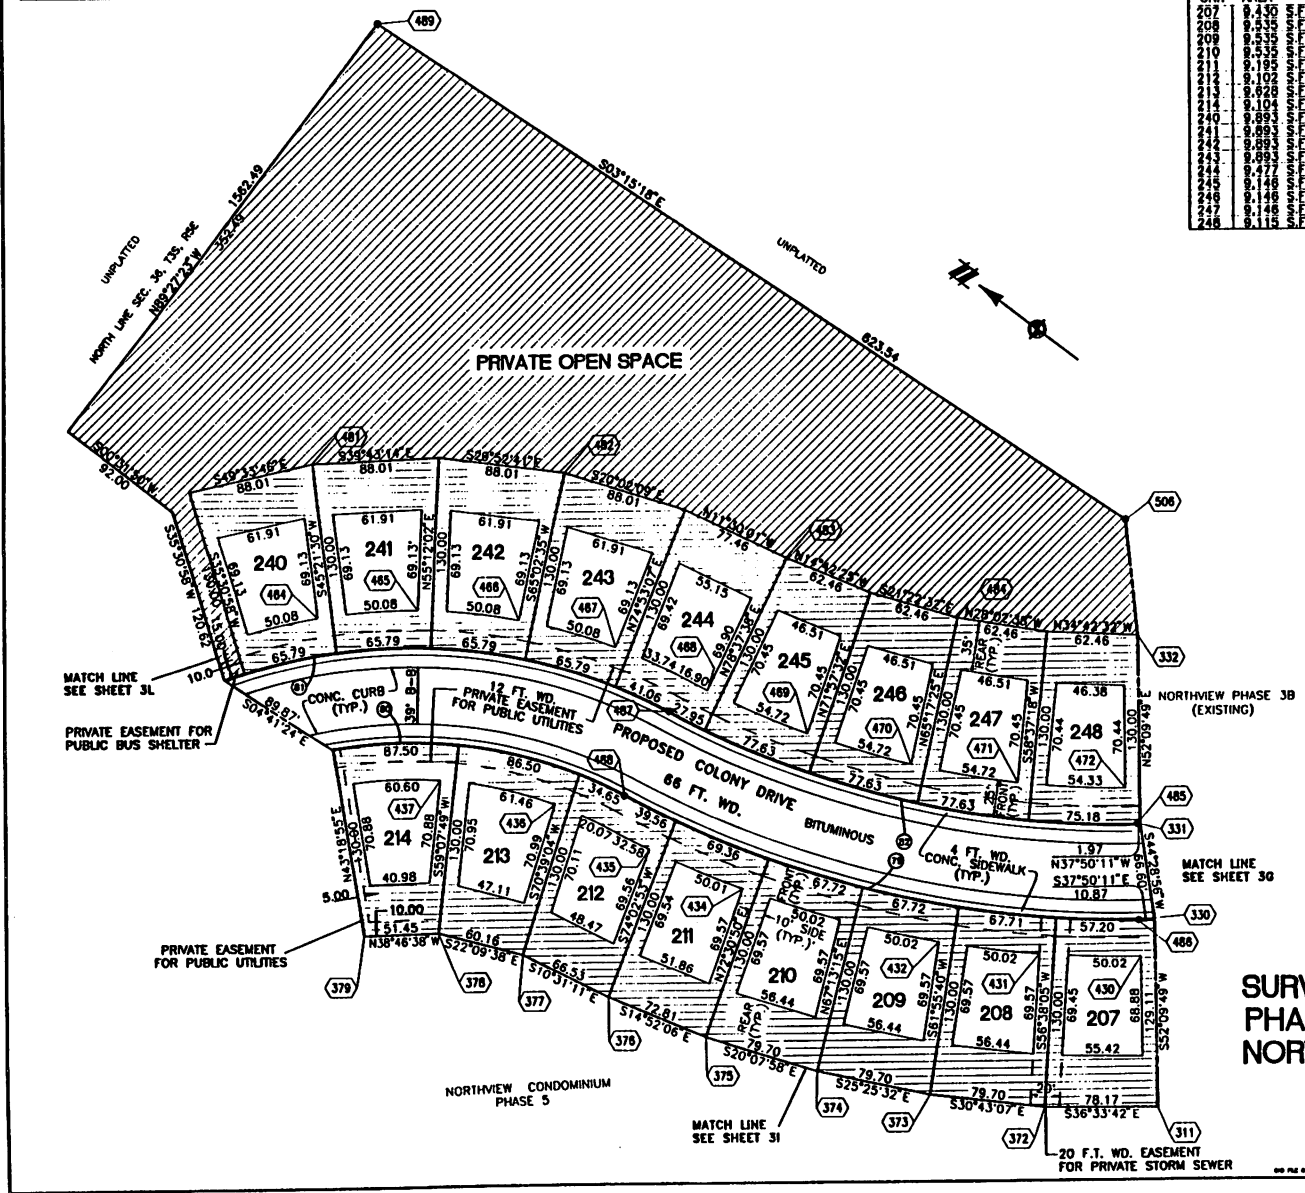


AS-BUILT DATE - FEBRUARY 29, 1998
Bruce C. Wallace
 BRUCE C. WALLACE
 LICENSED PROFESSIONAL ENGINEER NO. 39772
 ATWELL-HICKS, INC.
 540 AVIS DRIVE
 ANN ARBOR, MICHIGAN 48106
 TELEPHONE - (313) 994-4000

**SURVEY AND SITE PLAN
 PHASE 6 (UNITS 207-214 AND UNITS 240-248)
 NORTHVIEW**

3K

CLIENT: PETERS BUILDING COMPANY	SECTION 36 TOWN 3 SOUTH, RANGE 3 EAST CITY OF SALINE WASHTENAW COUNTY, MICHIGAN	ATWELL-HICKS, INC. CIVIL ENGINEERS, SURVEYORS, PLANNERS ANN ARBOR (810) 994-4000
	DATE: 02/20/98 SCALE: 1" = 40' FEET DRAWN BY: [Name]	DATE: 02/20/98 SCALE: 1" = 40' FEET JOB: 00206-00
		136-103K


Libert 00320 Page 49 of 67
 Copy

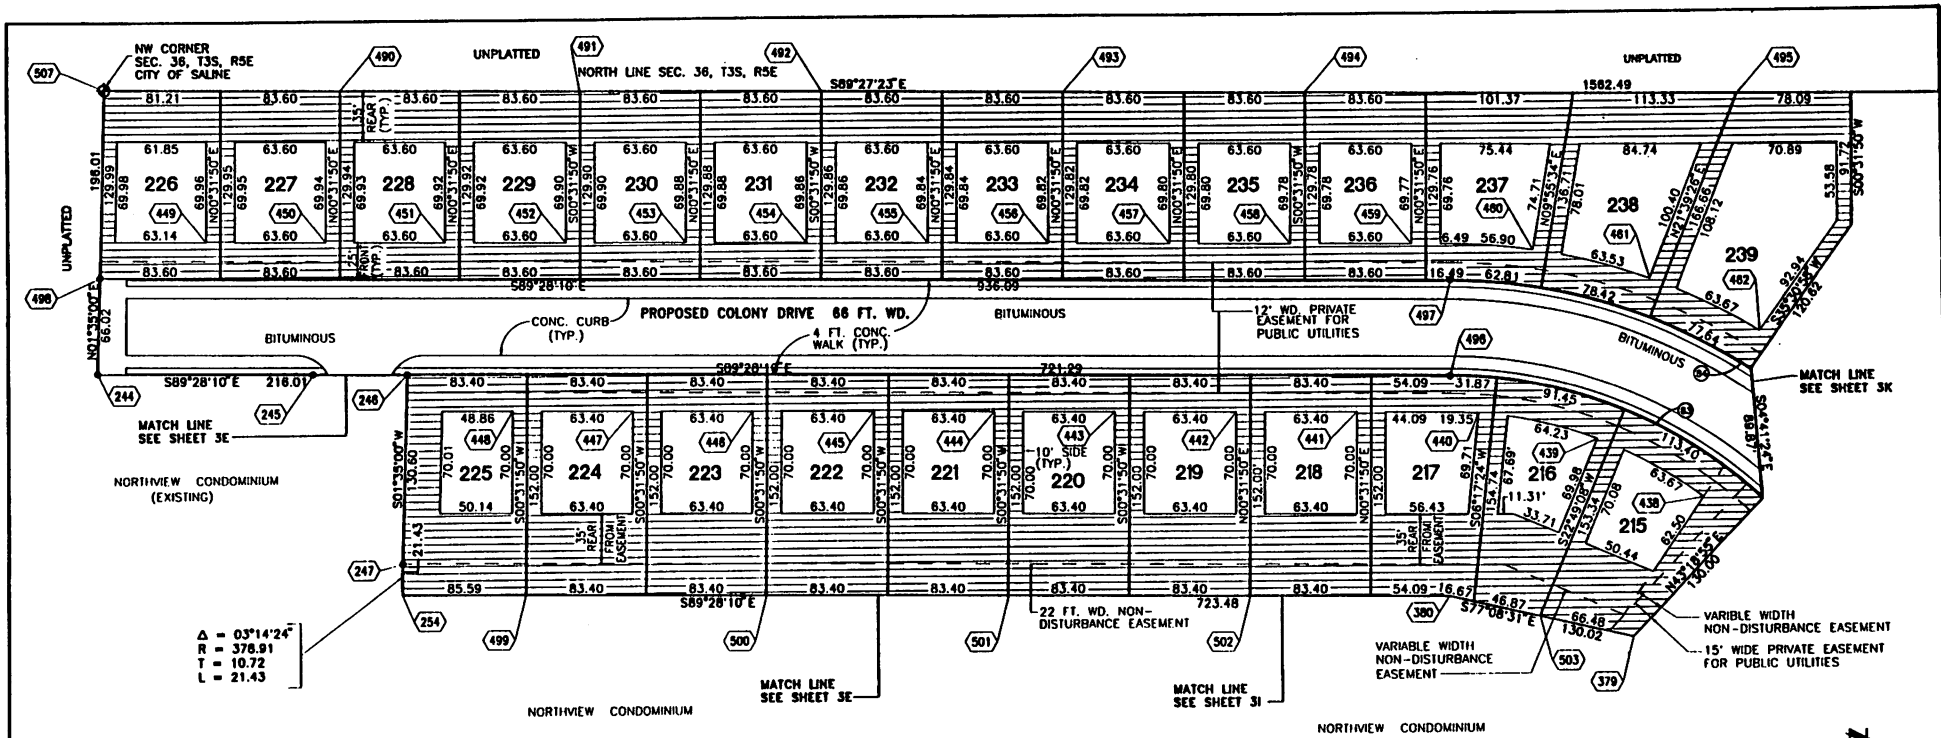

$\Delta = 03^{\circ}14'24''$
 $R = 378.91$
 $T = 10.72$
 $L = 21.43$

UNIT	AREA
215	12,515.8
216	10,717.8
217	1,525.0
218	12,577.7
219	12,577.7
220	12,577.7
221	12,577.7
222	12,577.7
223	12,577.7
224	12,577.7
225	12,577.7
226	10,710.0
227	10,883.0
228	10,883.0
229	10,880.0
230	10,858.0
231	10,857.0
232	10,855.0
233	10,854.0
234	10,852.0
235	10,851.0
236	10,849.0
237	11,864.0
238	14,023.0
239	16,249.0

- LEGEND:**
- (16) CURVE NUMBER
 - (285) COORDINATE POINT (SEE SHEET 4 FOR LIST)

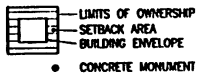

ALL PUBLIC STREET AND UTILITY IMPROVEMENTS HAVE BEEN BUILT

 BEARINGS OF THE BUILDING ENVELOPES ARE PARALLEL TO PERIMETER OF UNITS

 BEARINGS ARE RELATED TO THE PLAT OF COLONY ESTATES AS RECORDED IN LIBER 21 OF PLATS, PAGES 84-88, WASHTENAW COUNTY RECORDS.

CURVE CHART

CURVE	RADIUS	LENGTH	CHORD	BEARING	DELTA
83	317.00'	445.37'	409.83'	N49°13'15" W	80°29'50"
84	383.00'	538.09'	494.92'	S49°13'15" E	80°29'50"

AS-BUILT DATE - FEBRUARY 29, 1998

Bruce C. Wallace

BRUCE C. WALLACE
 LICENSED PROFESSIONAL ENGINEER NO. 39722
 ATWELL-HICKS, INC.
 540 AVIS DRIVE
 ANN ARBOR, MICHIGAN 48108
 TELEPHONE - (313) 994-6000




**SURVEY AND SITE PLAN
 PHASE 6 (UNITS 215-239)
 NORTHVIEW**

3L

CLIENT: PETERS BUILDING COMPANY	SECTION: 36 TOWNSHIP 3 SOUTH, RANGE 5 EAST	ATWELL-HICKS, INC. CIVIL ENGINEERS, SURVEYORS, PLANNERS ANN ARBOR
CITY OF SALINE WASHTENAW COUNTY, MICHIGAN	DATE: 02/29/98	SCALE: 1" = 40' FEET
DATE: 02/29/98	SCALE: 1" = 40' FEET	PROJECT NO: 138-193L

LIBER 00320 PAGE 0900
 PAGE 50 OF 67
 COPY

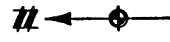

GENERAL NOTES

ALL UNITS WILL BE SERVICED WITH SANITARY SEWER AND WATER BY THE CITY OF SALINE. INFORMATION AS SHOWN IS FROM APPROVED CONSTRUCTION PLANS.

ALL UNITS WILL BE SERVICED WITH POWER BY THE DETROIT EDISON COMPANY. ALL UNITS WILL BE SERVICED WITH TELEPHONE BY THE GENERAL TELEPHONE COMPANY. ALL UNITS WILL BE SERVICED WITH CABLEVISION BY CLEAR CABLEVISION.


ALL PUBLIC UTILITIES AND STREET IMPROVEMENTS HAVE BEEN BUILT. ALL SANITARY AND STORM LEADS ARE 4" IN DIAMETER. ALL WATER LEADS ARE 1" IN DIAMETER.

NOT PLATTED

ALL PUBLIC STREET AND UTILITY IMPROVEMENTS HAVE BEEN BUILT

BEARINGS ARE RELATED TO THE PLAT OF COLONY ESTATES AS RECORDED IN LIBER 21 OF PLATS, PAGES 84-88, WASHTENAW COUNTY RECORDS.

**SURVEY AND SITE PLAN
PRIVATE OPEN SPACE
NORTHVIEW**

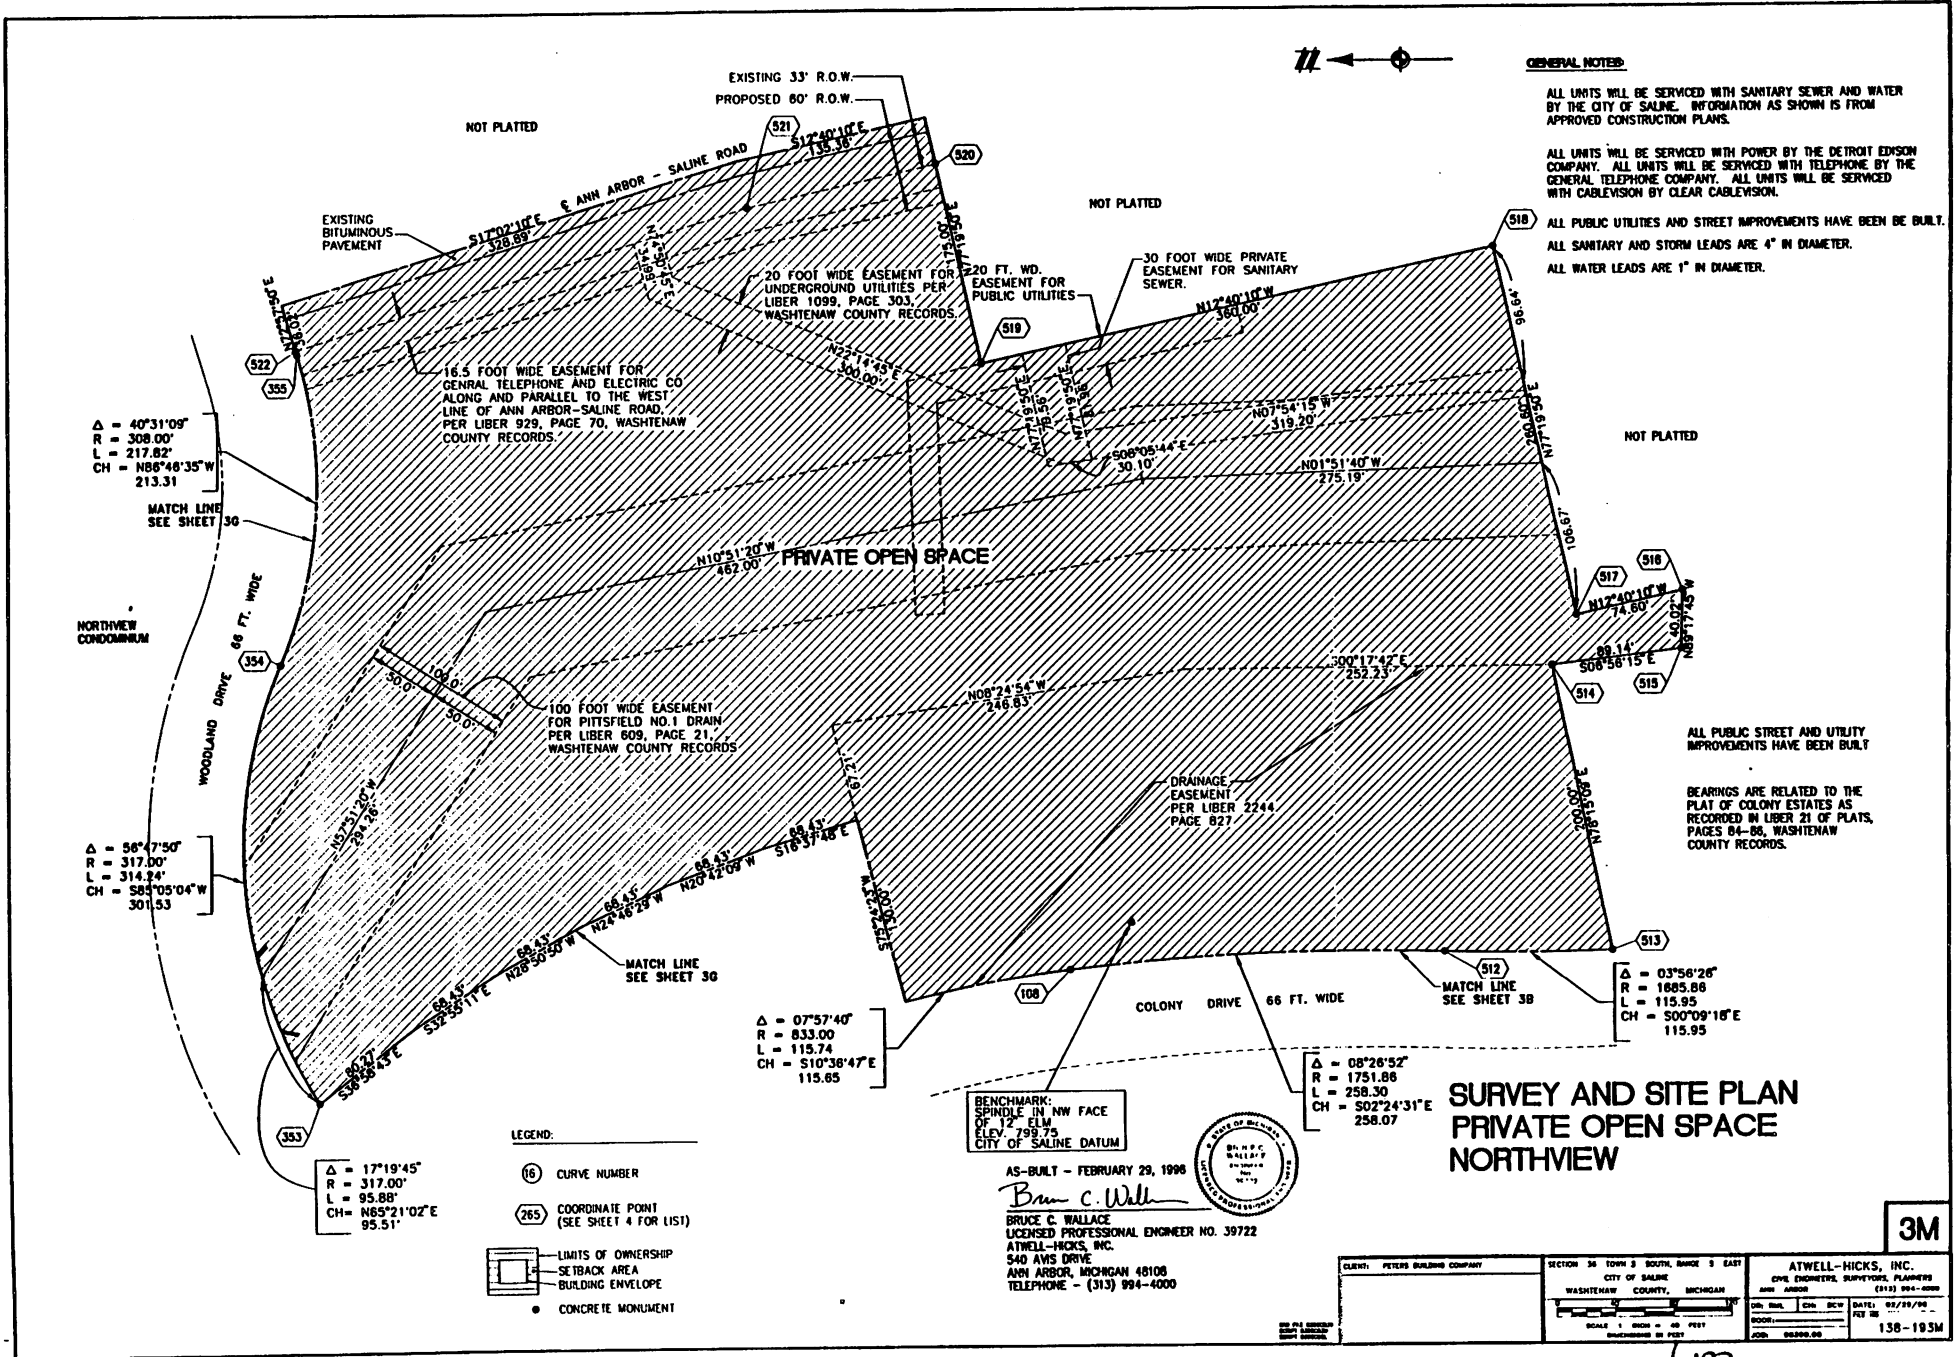

$\Delta = 40^{\circ}31'09''$
 $R = 308.00'$
 $L = 217.82'$
 $CH = N88^{\circ}48'35''W$
213.31

$\Delta = 56^{\circ}47'50''$
 $R = 317.00'$
 $L = 314.24'$
 $CH = S85^{\circ}05'04''W$
301.53

$\Delta = 07^{\circ}57'40''$
 $R = 833.00'$
 $L = 113.74'$
 $CH = S10^{\circ}38'47''E$
115.85

$\Delta = 08^{\circ}26'52''$
 $R = 1751.88'$
 $L = 258.30'$
 $CH = S02^{\circ}24'31''E$
258.07

$\Delta = 03^{\circ}56'26''$
 $R = 1885.86'$
 $L = 115.95'$
 $CH = S00^{\circ}09'18''E$
115.95

- LEGEND:**
- (16) CURVE NUMBER
 - (265) COORDINATE POINT (SEE SHEET 4 FOR LIST)
 - LIMITS OF OWNERSHIP
 - - - SETBACK AREA
 - ▭ BUILDING ENVELOPE
 - CONCRETE MONUMENT

$\Delta = 17^{\circ}19'45''$
 $R = 317.00'$
 $L = 95.88'$
 $CH = N65^{\circ}21'02''E$
95.51'

BENCHMARK:
SPINDLE IN NW FACE
OF 12" ELM
ELEV. 799.75
CITY OF SALINE DATUM

AS-BUILT - FEBRUARY 29, 1998

Bruce C. Wallace
BRUCE C. WALLACE
LICENSED PROFESSIONAL ENGINEER NO. 39722
ATWELL-HICKS, INC.
540 AHS DRIVE
ANN ARBOR, MICHIGAN 48108
TELEPHONE - (313) 994-4000



CLIENT: PETERS BUILDING COMPANY
DATE: 02/29/98
SCALE: 1" = 60 FEET
JOB: 0000000

SECTION 34 E 1/4 S 1/4 SW 1/4 E 1/4
CITY OF SALINE
WASHTENAW COUNTY, MICHIGAN
SCALE: 1" = 60 FEET
JOB: 0000000

ATWELL-HICKS, INC.
CIVIL ENGINEERS, SURVEYORS, PLANNERS
(413) 994-4000
DATE: 02/29/98
SCALE: 1" = 60 FEET
JOB: 0000000

3M

LIBER 03320 Page 0681
PAGE 51 OF 67
COPY

COORDINATE POINT NO.	NORTH COORDINATE	EAST COORDINATE	COORDINATE POINT NO.	NORTH COORDINATE	EAST COORDINATE	COORDINATE POINT NO.	NORTH COORDINATE	EAST COORDINATE	COORDINATE POINT NO.	NORTH COORDINATE	EAST COORDINATE	COORDINATE POINT NO.	NORTH COORDINATE	EAST COORDINATE
1	5199.8889	5111.316	25	5199.8889	5111.316	49	5199.8889	5111.316	73	5199.8889	5111.316	97	5199.8889	5111.316

AS BUILT DATE - FEBRUARY 29, 1998

ROBERT G. MACOMBER
 540 AINS DRIVE
 APT. 203, MICHIGAN 48106
 TELEPHONE - (313) 994-1800



COORDINATE LISTING NORTHVIEW

CLIENT: FEDERAL GOVERNMENT		PROJECT NO. 130-194	
DRAWN BY: ATWELL HICKS, INC.		DATE: 2-23-98	
CHECKED BY: ATWELL HICKS, INC.		SCALE: AS SHOWN	
DATE: 130-194			

COPY
 PAGES 52 OF 67
 LG 175371.dwg

COORDINATE POINT NO.	NORTH COORDINATE	EAST COORDINATE	COORDINATE POINT NO.	NORTH COORDINATE	EAST COORDINATE
372	6604.584	6318.190	453	7528.329	5477.514
373	6673.098	6277.479	454	7527.555	5561.110
374	6694.075	6243.262	455	7526.781	5644.707
375	7019.902	6215.831	456	7526.007	5728.303
376	7090.275	6197.146	457	7525.232	5811.900
377	7155.668	6185.001	458	7524.458	5895.496
378	7211.404	6162.308	459	7523.684	5979.093
379	7251.516	6130.064	460	7518.952	6062.259
380	7280.450	6003.327	461	7498.232	6143.033
381	7045.953	5995.792	462	7461.448	6218.026
382	7039.247	6082.619	463	7409.175	6284.984
383	7076.500	6084.506	464	7356.445	6331.024
384	6690.678	6123.445	465	7296.622	6367.372
385	6662.446	6180.615	466	7231.466	6392.959
386	6728.240	6130.721	467	7162.435	6407.682
387	6668.472	6073.186	468	7089.916	6425.493
388	6616.635	5923.138	469	7019.959	6451.625
389	6624.556	5947.876	470	6953.510	6485.704
390	6612.835	5999.308	471	6891.777	6527.035
391	6630.393	6050.297	472	6857.958	6609.797
392	7617.760	6020.314	473	6708.573	6585.159
393	6592.050	5924.981	474	5788.151	5216.007
394	6546.664	5925.996	475	5782.744	5150.226
395	6500.370	5481.224	476	5679.755	5018.791
396	6451.131	5439.712	477	5609.008	5025.128
397	6409.177	5401.653	478	6048.716	5028.990
398	6342.746	5367.225	479	6192.639	5032.974
399	6289.195	5336.568	480	6346.054	5037.209
400	6259.495	5309.883	481	7475.926	6356.808
401	6169.206	5287.237	482	7311.911	6466.898
402	6107.479	5268.753	483	7173.321	6512.495
403	6047.704	5254.518	484	7054.735	6551.121
404	6081.098	5224.596	485	6870.067	6512.179
405	6019.906	5219.058	486	6829.582	6460.054
406	5952.561	5217.068	487	7175.188	6380.113
407	5882.960	5214.071	488	7164.895	6314.921
408	5852.392	5212.641	489	7622.228	6635.312
409	6873.352	5435.871	490	7635.527	5237.696
410	6873.987	5435.871	491	7633.928	5404.889
411	6394.652	5310.035	492	7632.430	5572.082
412	6349.289	5310.035	493	7630.882	5729.275
413	6301.481	5292.118	494	7629.334	5806.468
414	6251.585	5282.138	495	7628.572	6204.754
415	6397.992	5283.958	496	7413.443	6004.735
416	6341.978	5283.958	497	7408.440	6005.346
417	6284.255	5287.081	498	7296.356	5365.461
418	6229.032	5183.840	499	7289.812	5532.254
419	6164.521	5148.212	500	7281.267	5899.047
420	6102.940	5148.212	501	7281.267	5899.047
421	6040.512	5127.761	502	7281.267	5899.047
422	5977.461	5122.787	503	7281.267	5899.047
423	5914.014	5122.787	504	7281.267	5899.047
424	5850.399	5122.787	505	6981.397	5526.416
425	5786.847	5124.824	506	6959.694	5712.892
426	5724.200	5135.318	507	6931.023	5712.892
427	5665.024	5148.397	508	6904.352	5712.892
428	5605.024	5160.844	509	6874.352	5712.892
429	6813.561	6400.439	510	6844.352	5712.892
430	6870.719	6385.479	511	6814.352	5712.892
431	6931.364	6385.479	512	6784.352	5712.892
432	6994.975	6336.282	513	6754.352	5712.892
433	7061.010	6313.037	514	6724.352	5712.892
434	7128.931	6291.998	515	6694.352	5712.892
435	7200.090	6281.265	516	6664.352	5712.892
436	7273.774	6247.156	517	6634.352	5712.892
437	7348.813	6178.648	518	6604.352	5712.892
438	7388.324	6105.759	519	6574.352	5712.892
439	7408.624	6023.813	520	6544.352	5712.892
440	7408.037	5940.413	521	6514.352	5712.892
441	7408.037	5857.016	522	6484.352	5712.892
442	7408.810	5773.620	523	6454.352	5712.892
443	7409.582	5690.223	524	6424.352	5712.892
444	7410.354	5606.827	525	6394.352	5712.892
445	7411.126	5523.431	526	6364.352	5712.892
446	7411.899	5440.034	527	6334.352	5712.892
447	7412.671	5356.638	528	6304.352	5712.892
448	7413.443	5273.242	529	6274.352	5712.892
449	7531.425	5143.128	530	6244.352	5712.892
450	7550.651	5228.725	531	6214.352	5712.892
451	7529.877	5310.321	532	6184.352	5712.892
452	7528.103	5393.918	533	6154.352	5712.892

COORDINATE LISTING
NORTHVIEW

4A

AS-BUILT DATE - FEBRUARY 29, 1986
BRUCE C. WILLIAMS
LICENSED PROFESSIONAL ENGINEER NO. 39172
ATWELL-HICKS, INC.
540 AHS DRIVE
ANN ARBOR, MICHIGAN 48106
TELEPHONE - (313) 994-6500



CLIENT: FITZGERALD COMPANY

SECTION: 30' TYPICAL SOUTH, DRAWING 5 1111

DATE: 02/29/86

PROJECT: 138-194A

COPY
PAGE 53 OF 67
3090

LEGEND:

EXISTING	DESCRIPTION	AS-BUILT
—S—	SANITARY SEWER	S
—R—	STORM SEWER	R
—W—	WATER MAIN	W
—G—	GAS LINE	G
—E—	UNDERGROUND ELECTRIC	E
○	SANITARY MANHOLE	● S
□	TRANSFORMER	■
■	CATCH BASIN	■
h ○	HYDRANT	h ○
—T—	METER LOCATION	—T—
—T—	UNDERGROUND TELEPHONE	T
—C—	UNDERGROUND CABLEVISION	C
—E—	OVERHEAD ELECTRIC	—E—
—T—	OVERHEAD TELEPHONE	—T—
—C—	OVERHEAD CABLEVISION	—C—
—W—	WATER LEAD STOP BOX	—W—
—*	LIGHT POLE	—*

GENERAL NOTATIONS

ALL UNITS WILL BE SERVICED WITH SANITARY SEWER AND WATER BY THE CITY OF SALINE, INFORMATION AS SHOWN OBTAINED FROM APPROVED CONSTRUCTION PLANS.


ALL UNITS WILL BE SERVICED WITH POWER BY DETROIT EDISON COMPANY. ALL UNITS WILL BE SERVICED WITH TELEPHONE BY GENERAL TELEPHONE COMPANY. ALL UNITS WILL BE SERVICED WITH CABLEVISION BY CLEAR CABLE. POWER, TELEPHONE AND CABLEVISION LINES AS SHOWN OBTAINED FROM DETROIT EDISON COMPANY CONSTRUCTION PLANS.

ALL UNITS WILL BE SERVICED WITH GAS BY MICHIGAN CONSOLIDATED GAS COMPANY. INFORMATION AS SHOWN OBTAINED FROM MICHIGAN CONSOLIDATED GAS COMPANY CONSTRUCTION PLANS.

STORM SEWER LOCATIONS SHOWN ARE OBTAINED FROM APPROVED CONSTRUCTION PLANS.

LEAD SIZES

ALL UNITS	4" S
	4" R
	3/4" W* * UNLESS NOTED OTHERWISE

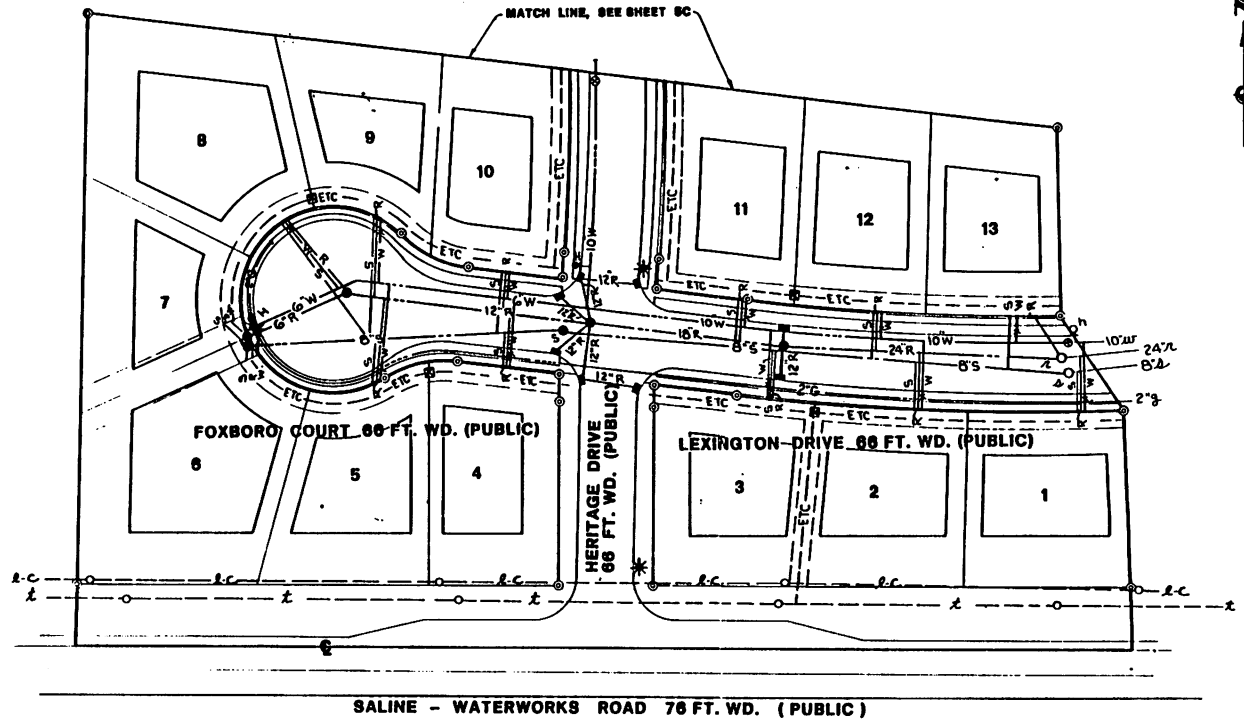

ALL PUBLIC STREET AND UTILITY IMPROVEMENTS HAVE BEEN BUILT

AS-BUILT DATE - FEBRUARY 29, 1996

ROBERT G. MACOMBER
PROFESSIONAL SURVEYOR NO. 27453
ATWELL-HICKS, INC.
540 AVIS DRIVE
ANN ARBOR, MICHIGAN 48108
TELEPHONE - (313) 994-4000




**UTILITY PLAN
PHASE 1 (UNITS 1-13)
NORTHVIEW**

5

CLIENT PETERS BUILDING COMPANY	SECTION 36 TOWN 3 SOUTH RANGE 5 EAST CITY OF SALINE MICHIGAN COUNTY: MICHIGAN	ATWELL-HICKS, INC. CIVIL ENGINEERS SURVEYORS PLANNERS ANN ARBOR
	DATE 2-29-96	
	SCALE 1" = 40' - 0.0'	JOB 90390
	DATE 2-29-96	138-195

LIBRARY
03320 Page 0684
PAGE 54 OF 67
COPY

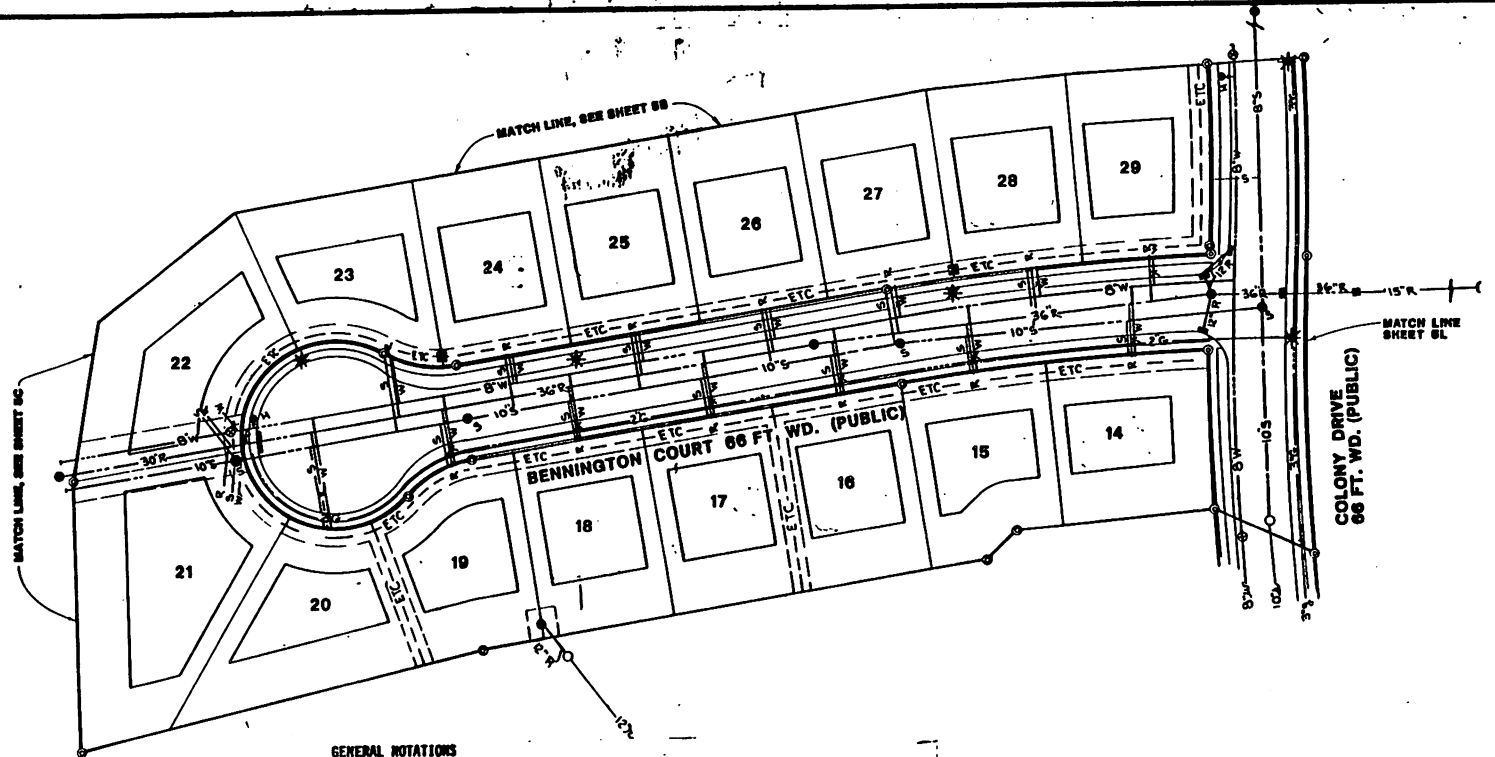

LEAD SIZES	
ALL UNITS	4" S
	4" R
	3/4" N* * UNLESS NOTED OTHERWISE

GENERAL NOTATIONS

ALL UNITS WILL BE SERVICED WITH SANITARY SEWER AND WATER BY THE CITY OF SALINE. INFORMATION AS SHOWN OBTAINED FROM APPROVED CONSTRUCTION PLANS.

ALL UNITS WILL BE SERVICED WITH POWER BY DETROIT EDISON COMPANY. ALL UNITS WILL BE SERVICED WITH TELEPHONE BY GENERAL TELEPHONE COMPANY. ALL UNITS WILL BE SERVICED WITH CABLEVISION BY CLEAR CABLE. POWER, TELEPHONE AND CABLEVISION LINES AS SHOWN OBTAINED FROM DETROIT EDISON COMPANY CONSTRUCTION PLANS.

A/C UNITS WILL BE SERVICED WITH GAS BY MICHIGAN CONSOLIDATED GAS COMPANY. INFORMATION AS SHOWN OBTAINED FROM MICHIGAN CONSOLIDATED GAS COMPANY CONSTRUCTION PLANS.

STORM SEWER LOCATIONS SHOWN ARE OBTAINED FROM APPROVED CONSTRUCTION PLANS.

ALL PUBLIC STREET AND UTILITY IMPROVEMENTS HAVE BEEN BUILT

AS-BUILT DATE - FEBRUARY 29, 1996



ROBERT G. MACOMBER
PROFESSIONAL SURVEYOR NO. 27453
ATWELL-HICKS, INC.
540 AVIS DRIVE
ANN ARBOR, MICHIGAN 48108
TELEPHONE - (313) 994-4000

LEGEND

EXISTING	DESCRIPTION	AS-BUILT
—S—	SANITARY SEWER	S
—R—	STORM SEWER	R
—W—	WATER MAIN	W
—G—	GAS LINE	G
—E—	UNDERGROUND ELECTRIC	E
○	SANITARY MANHOLE	○ S
□	TRANSFORMER	□
■	CATCH BASIN	■
○+	HYDRANT	○+
—M—	METER LOCATION	—M—
—T—	UNDERGROUND TELEPHONE	T
—C—	UNDERGROUND CABLEVISION	C
—W	WATER LEAD STOP BOX	—W
—*	LIGHT POLE	*

**UTILITY PLAN
PHASE 1 (UNITS 14-29)
NORTHVIEW**

5A

CLIENT PETERS BUILDING COMPANY	SECTION 36, TOWN 5 SOUTH RANGE 5 EAST CITY OF SALINE WADSWORTH COUNTY, MICHIGAN	ATWELL-HICKS, INC. CIVIL ENGINEERS SURVEYORS, PLANNERS AND ARCHITECTS 115 000-0000
	DATE 2 21 96	DATE 2 21 96
	SCALE 1" = 40' FEET DIMENSIONS IN FEET	BOOK 62 90390
		138-195A

COPY
PAGE 55 OF 67
LITER 00020 1388 0005

GENERAL NOTATIONS:

ALL UNITS WILL BE SERVICED WITH SANITARY SEWER AND WATER BY THE CITY OF SALINE. INFORMATION AS SHOWN OBTAINED FROM APPROVED CONSTRUCTION PLANS.

ALL UNITS WILL BE SERVICED WITH POWER BY THE DETROIT EDISON COMPANY. ALL UNITS WILL BE SERVICED WITH TELEPHONE BY THE GENERAL TELEPHONE COMPANY. ALL UNITS WILL BE SERVICED WITH CABLEVISION BY CLEAR CABLE. POWER, TELEPHONE AND CABLEVISION LINES AS SHOWN OBTAINED FROM DETROIT EDISON COMPANY CONSTRUCTION PLANS.


ALL UNITS WILL BE SERVICED WITH GAS BY MICHIGAN CONSOLIDATED GAS COMPANY. INFORMATION AS SHOWN OBTAINED FROM MICHIGAN CONSOLIDATED GAS COMPANY CONSTRUCTION PLANS.

STORM SEWER LOCATIONS SHOWN ARE OBTAINED FROM APPROVED CONSTRUCTION PLANS.

LEGEND:		
EXISTING	DESCRIPTION	AS-BUILT
—A—	SANITARY SEWER	—S—
—R—	STORM SEWER	—R—
—W—	WATER MAIN	—W—
—G—	GAS MAIN	—G—
—E—	UNDERGROUND ELECTRIC	—E—
—T—	UNDERGROUND TELEPHONE	—T—
—C—	UNDERGROUND CABLEVISION	—C—
○	SANITARY MANHOLE	○
●	CATCH BASIN	●
○	WATER VALVE	○
○	HYDRANT	○
○	METER LOCATION	○
□	TRANSFORMER	□
○	WATER LEAD STOP BOX	○
—OE—	OVERHEAD ELECTRIC	—OE—
—OT—	OVERHEAD TELEPHONE	—OT—
—OC—	OVERHEAD CABLEVISION	—OC—
—	LIGHT POLE	—

LEAD SIZES:		
UTILITY	SIZE	UNITS
SANITARY	4"	ALL
STORM	4"	ALL
WATER	3/4" R	ALL

* UNLESS OTHERWISE NOTED

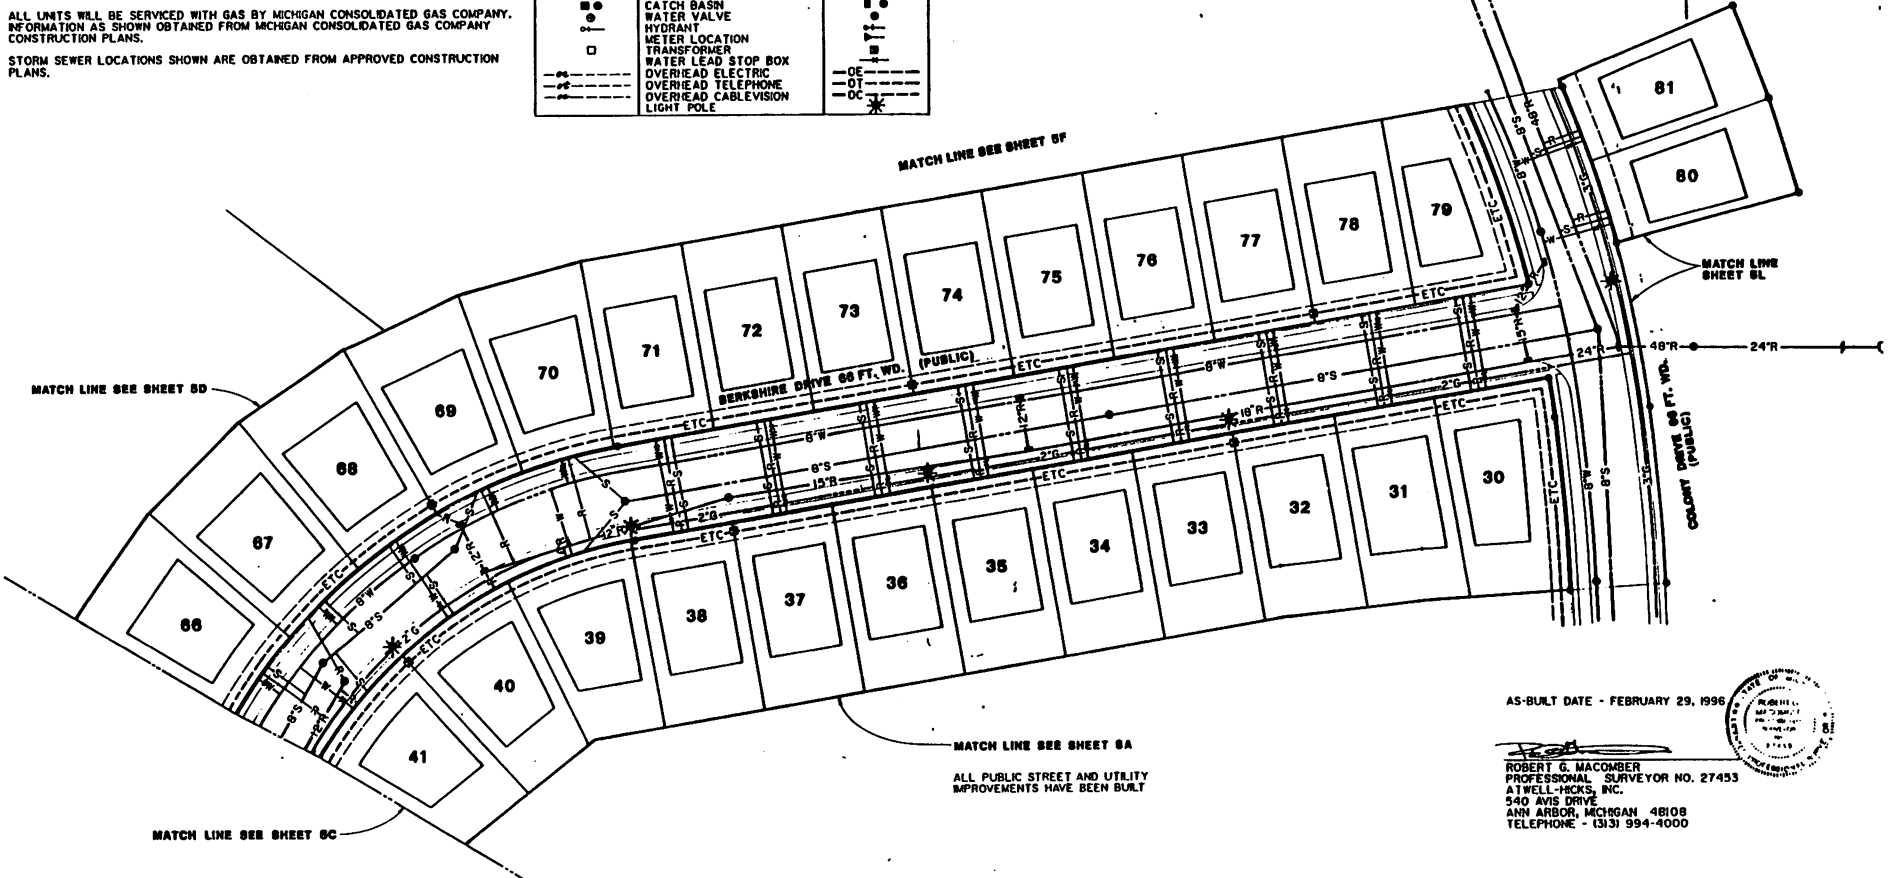

AS-BUILT DATE - FEBRUARY 29, 1996



ROBERT G. MACOMBER
PROFESSIONAL SURVEYOR NO. 27453
ATWELL-HICKS, INC.
540 AVIS DRIVE
ANN ARBOR, MICHIGAN 48108
TELEPHONE - (313) 994-4000

MATCH LINE SEE SHEET 8A
ALL PUBLIC STREET AND UTILITY IMPROVEMENTS HAVE BEEN BUILT

**UTILITY PLAN
PHASE II (UNITS 30-41
& UNITS 66-81)
NORTHVIEW**

5B

CLIENT: PETERS BUILDING COMPANY	SECTION: 36, TOWN 8, SOUTH RANGE 8 EAST	ATWELL-HICKS, INC.
	CITY OF SALINE, MICHIGAN	ENGINEERS AND ARCHITECTS
	WASHTENAW COUNTY, MICHIGAN	PLANNING
		DATE: 2-27-96
		SCALE: 1" = 40' (SEE PLAN)
		NO. 196-1958

LIBR 03320 Page 0686
COPY PAGE 56 OF 67

GENERAL NOTATIONS:

ALL UNITS WILL BE SERVICED WITH SANITARY SEWER AND WATER BY THE CITY OF SALINE. INFORMATION AS SHOWN OBTAINED FROM APPROVED CONSTRUCTION PLANS.

ALL UNITS WILL BE SERVICED WITH POWER BY THE DETROIT EDISON COMPANY. ALL UNITS WILL BE SERVICED WITH TELEPHONE BY THE GENERAL TELEPHONE COMPANY. ALL UNITS WILL BE SERVICED WITH CABLEVISION BY CLEAR CABLE. POWER, TELEPHONE AND CABLEVISION LINES AS SHOWN OBTAINED FROM DETROIT EDISON COMPANY CONSTRUCTION PLANS.

ALL UNITS WILL BE SERVICED WITH GAS BY MICHIGAN CONSOLIDATED GAS COMPANY. INFORMATION AS SHOWN OBTAINED FROM MICHIGAN CONSOLIDATED GAS COMPANY CONSTRUCTION PLANS.


STORM SEWER LOCATIONS SHOWN ARE OBTAINED FROM APPROVED CONSTRUCTION PLANS.

LEGEND:

EXISTING	DESCRIPTION	AS-BUILT
—▲—	SANITARY SEWER	—S—
—△—	STORM SEWER	—R—
—W—	WATER MAIN	—G—
—F—	GAS MAIN	—E—
—U—	UNDERGROUND ELECTRIC	—T—
—A—	UNDERGROUND TELEPHONE	—C—
—G—	UNDERGROUND CABLEVISION	
○	SANITARY MANHOLE	
●	CATCH BASIN	
○	WATER VALVE	
○	HYDRANT	
□	METER LOCATION	
□	TRANSFORMER	
□	WATER LEAD STOP BOX	
—○—	OVERHEAD ELECTRIC	—OE—
—○—	OVERHEAD TELEPHONE	—OT—
—○—	OVERHEAD CABLEVISION	—OC—
—○—	LIGHT POLE	—L—

LEAD SIZES:		
UTILITY	SIZE	UNITS
SANITARY	4"	ALL
STORM	4"	ALL
WATER	3/4"	ALL

• UNLESS OTHERWISE NOTED

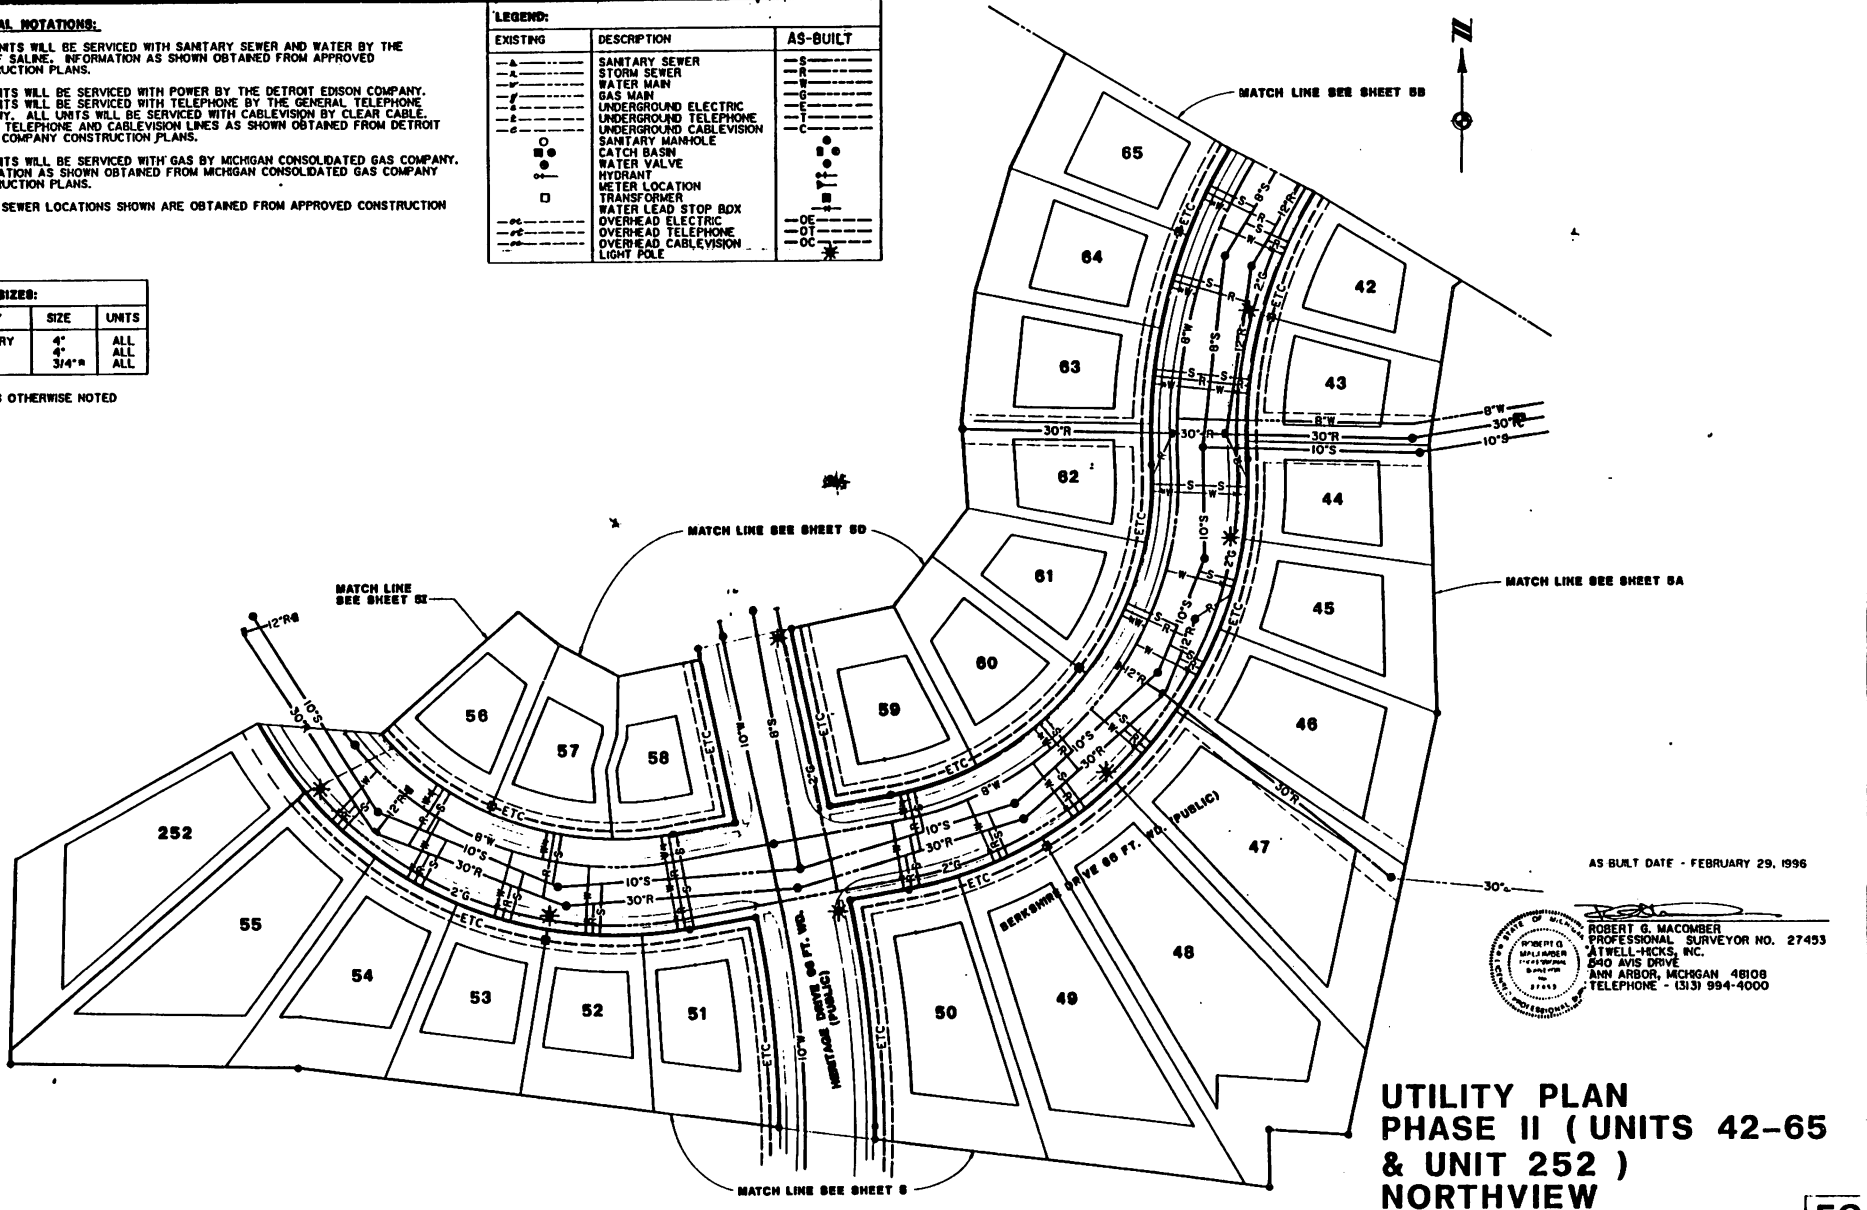

AS BUILT DATE - FEBRUARY 29, 1996

STATE OF MICHIGAN
 ROBERT G. MACOMBER
 PROFESSIONAL SURVEYOR NO. 27493
 ATWELL-HICKS, INC.
 5940 AVIS DRIVE
 ANN ARBOR, MICHIGAN 48108
 TELEPHONE - (313) 994-4000


**UTILITY PLAN
 PHASE II (UNITS 42-65
 & UNIT 252)
 NORTHVIEW**

5C


ALL PUBLIC STREET AND UTILITY IMPROVEMENTS HAVE BEEN BUILT

CLIENT: PETER'S BUILDING COMPANY	SECTION 30: TOWN 5 NORTH RANGE 9 EAST CITY OF SALINE, WASHINGTON COUNTY, MICHIGAN	ATWELL-HICKS, INC. CIVIL ENGINEER, SURVEYOR, PLANNER ANN ARBOR
	DATE: 2-21-96	DR: JHM / CH: EAM
	SCALE: 1" = 40' FEET	PLS NUMBER: 13B-195C
	REVISIONS: 00	200 90940

COPY
 PAGE 57 OF 67
 1996 FEB 21 10:00 AM

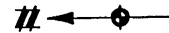

LEGEND		
EXISTING	DESCRIPTION	PROPOSED
—▲—	SANITARY SEWER	—S—
—A—	STORM SEWER	—R—
—W—	WATER MAIN	—B—
—O—	GAS MAIN	—E—
—•—	UNDERGROUND ELECTRIC	—T—
—•—	UNDERGROUND TELEPHONE	—C—
—•—	UNDERGROUND CABLEVISION	
○	SANITARY MANHOLE	●
○	CATCHBASIN	●
○	WATER VALVE	●
○	HYDRANT	●
○	METER LOCATION	●
□	TRANSFORMER	□
□	WATER LEAD STOP BOX	□
□	LIGHT POLE	□

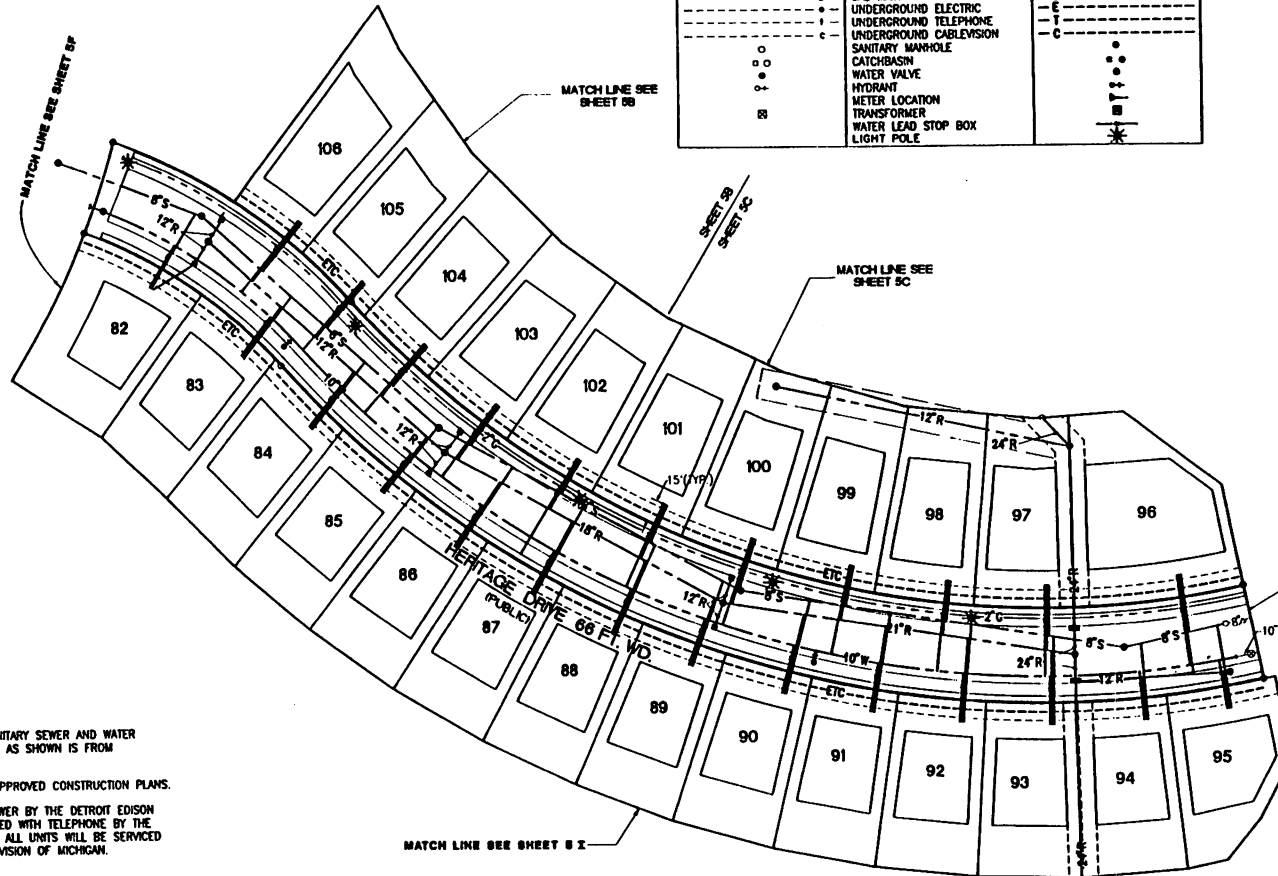

AS-BUILT DATE - FEBRUARY 29, 1996

ROBERT G. MACOMBER
 PROFESSIONAL SURVEYOR NO. 27453
 ATWELL-MICKS, INC.
 540 AVIS DRIVE
 ANN ARBOR, MICHIGAN 48108
 TELEPHONE - (313) 994-4000

GENERAL NOTES

ALL UNITS WILL BE SERVICED WITH SANITARY SEWER AND WATER BY THE CITY OF SALINE. INFORMATION AS SHOWN IS FROM APPROVED CONSTRUCTION PLANS.

STORM SEWER LOCATIONS ARE FROM APPROVED CONSTRUCTION PLANS.

ALL UNITS WILL BE SERVICED WITH POWER BY THE DETROIT EDISON COMPANY. ALL UNITS WILL BE SERVICED WITH TELEPHONE BY THE MICHIGAN BELL TELEPHONE COMPANY. ALL UNITS WILL BE SERVICED WITH CABLEVISION BY COLUMBIA CABLEVISION OF MICHIGAN.

ALL PUBLIC UTILITY AND STREET IMPROVEMENTS HAVE BEEN BUILT

ALL SANITARY AND STORM LEADS ARE 4" IN DIAMETER.

ALL WATER LEADS ARE 3/4" IN DIAMETER

**UTILITY PLAN
 PHASE 3A (UNITS 82-106)
 NORTHVIEW**

5D

CLIENT: PETERS BUILDING COMPANY	SECTION 36 TOWN 5 SOUTH RANGE 5 EAST CITY OF SALINE WASHTENAW COUNTY, MICHIGAN	ATWELL-MICKS, INC. CIVIL ENGINEERS, SURVEYORS, PLANNERS ANN ARBOR (313) 994-4000
	SCALE: 1" = 40' FEET SHOWING IN FEET	DATE: 2-29-96 JOB: 00390.03
		138-195D

LIBER 03320
 PAGE 58 OF 67
 COPY
 0688

NOTES:

ALL UNITS WILL BE SERVICED WITH SANITARY SEWER AND WATER BY THE CITY OF SALINE. INFORMATION AS SHOWN IS FROM APPROVED CONSTRUCTION PLANS.

STORM SEWER LOCATIONS ARE FROM APPROVED CONSTRUCTION PLANS.

ALL UNITS WILL BE SERVICED WITH POWER BY THE DETROIT EDISON COMPANY. ALL UNITS WILL BE SERVICED WITH TELEPHONE BY THE GENERAL TELEPHONE COMPANY. ALL UNITS WILL BE SERVICED WITH CABLEVISION BY CLEAR CABLE.


ELECTRIC, TELEPHONE, CABLE AND GAS LOCATIONS WILL BE SHOWN ON THE AS-BUILT PLANS.

ALL PUBLIC UTILITY AND STREET IMPROVEMENTS HAVE BEEN BUILT.

ALL SANITARY AND STORM LEADS ARE 4" IN DIAMETER.

ALL WATER LEADS ARE 3/4" IN DIAMETER.

LEGEND:		
EXISTING	DESCRIPTION	PROPOSED
---	STORM	R ---
Δ ---	SANITARY	S ---
W ---	WATER	W ---
UE ---	UNDERGROUND ELECTRIC	UE ---
G ---	GAS	G ---
UT ---	UNDERGROUND TELEPHONE	UT ---
○	MANHOLE	○
□	CATCH BASIN	□
⊕	HYDRANT	⊕
⊗	WATER STOP BOX	⊗
⊙	LIGHT POLE	⊙

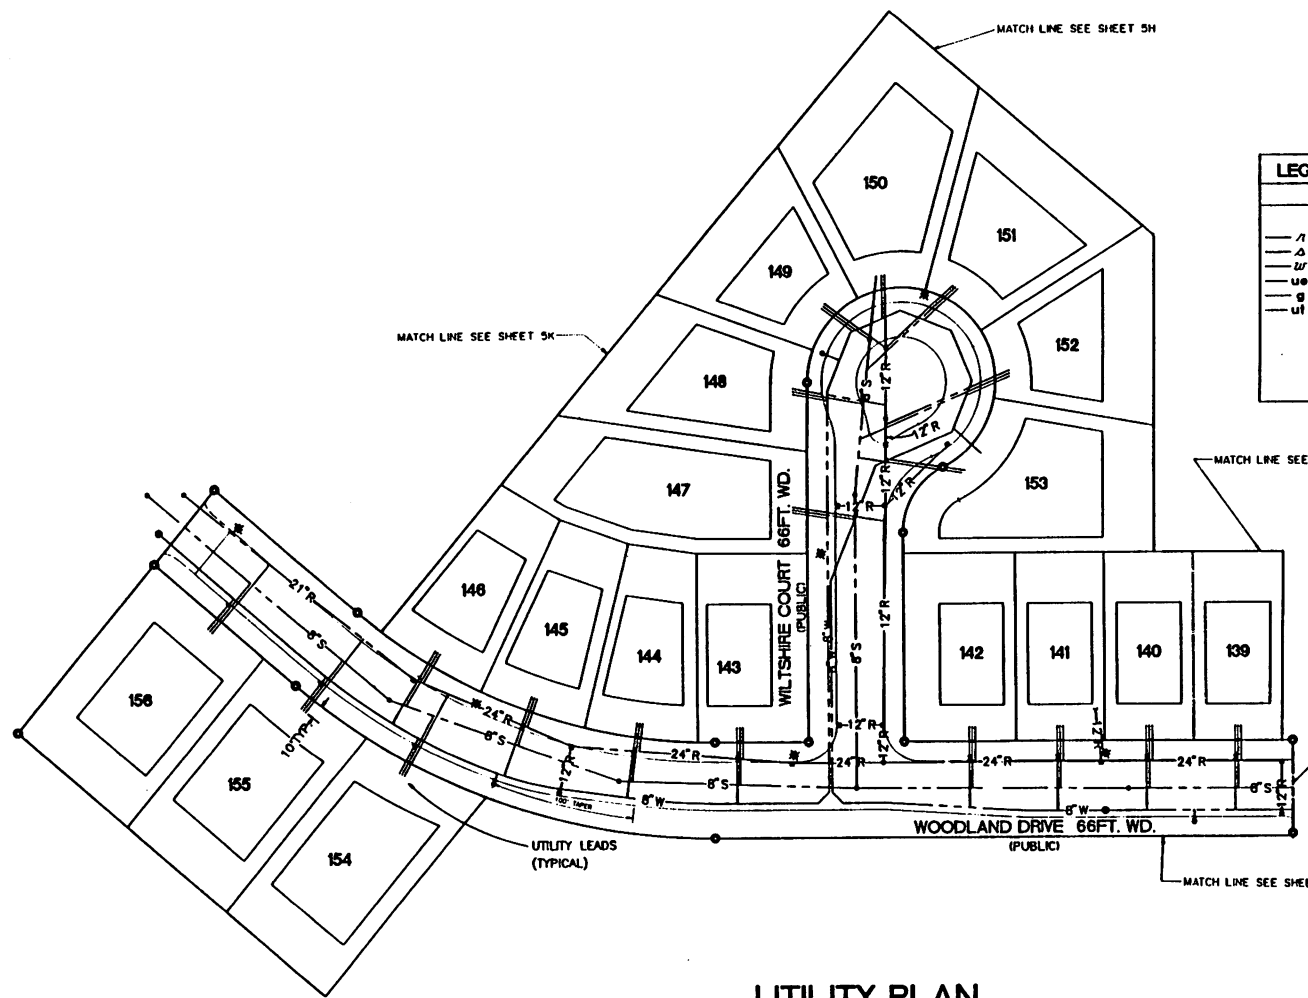

AS-BUILT DATE - FEBRUARY 29, 1996

ROBERT C. MACOMBER
 PROFESSIONAL SURVEYOR NO. 27453
 ATWELL-HICKS, INC.
 540 AVIS DRIVE
 ANN ARBOR, MICHIGAN 48108
 TELEPHONE - (313) 994-4000



MATCH LINE, SEE SHEET 5F

**UTILITY PLAN
 PHASE 3B (UNITS 139-156)
 NORTHVIEW**

CLIENT: PETERS BUILDING COMPANY	SECTION: 36 TOWN 5 SOUTH, RANGE 5 EAST	ATWELL-HICKS, INC.
	CITY OF SALINE	CIVIL ENGINEERS, SURVEYORS, PLANNERS
	WASHINGTON COUNTY, MICHIGAN	ANN ARBOR (313) 994-4000
		DATE: 2-29-96
		BY: RHM/CM/BW
		JOB: 90356.31
	SCALE: 1" = 30' (SEE PLAN)	138-195E

LIBRARY
 05-20 Page 66 of 67
 COPY

LEGEND:		
EXISTING	DESCRIPTION	PROPOSED
---	STORM	R
-Δ-	SANITARY	S
-W-	WATER	W
-UE-	UNDERGROUND ELECTRIC	UE
-G-	GAS	G
-UT-	UNDERGROUND TELEPHONE	UT
○	MANHOLE	○
■	CATCH BASIN	■
⊕	HYDRANT	⊕
⊗	WATER STOP BOX	⊗
⋆	LIGHT POLE	⋆



NOTES:

ALL UNITS WILL BE SERVICED WITH SANITARY SEWER AND WATER BY THE CITY OF SALINE. INFORMATION AS SHOWN IS FROM APPROVED CONSTRUCTION PLANS.

STORM SEWER LOCATIONS ARE FROM APPROVED CONSTRUCTION PLANS.


ALL UNITS WILL BE SERVICED WITH POWER BY THE DETROIT EDISON COMPANY. ALL UNITS WILL BE SERVICED WITH TELEPHONE BY THE GENERAL TELEPHONE COMPANY. ALL UNITS WILL BE SERVICED WITH CABLEVISION BY CLEAR CABLE.

ELECTRIC, TELEPHONE, CABLE AND GAS LOCATIONS WILL BE SHOWN ON THE AS-BUILT PLANS.

ALL PUBLIC UTILITY AND STREET IMPROVEMENTS HAVE BEEN BUILT.

ALL SANITARY AND STORM LEADS ARE 4" IN DIAMETER.

ALL WATER LEADS ARE 3/4" IN DIAMETER.

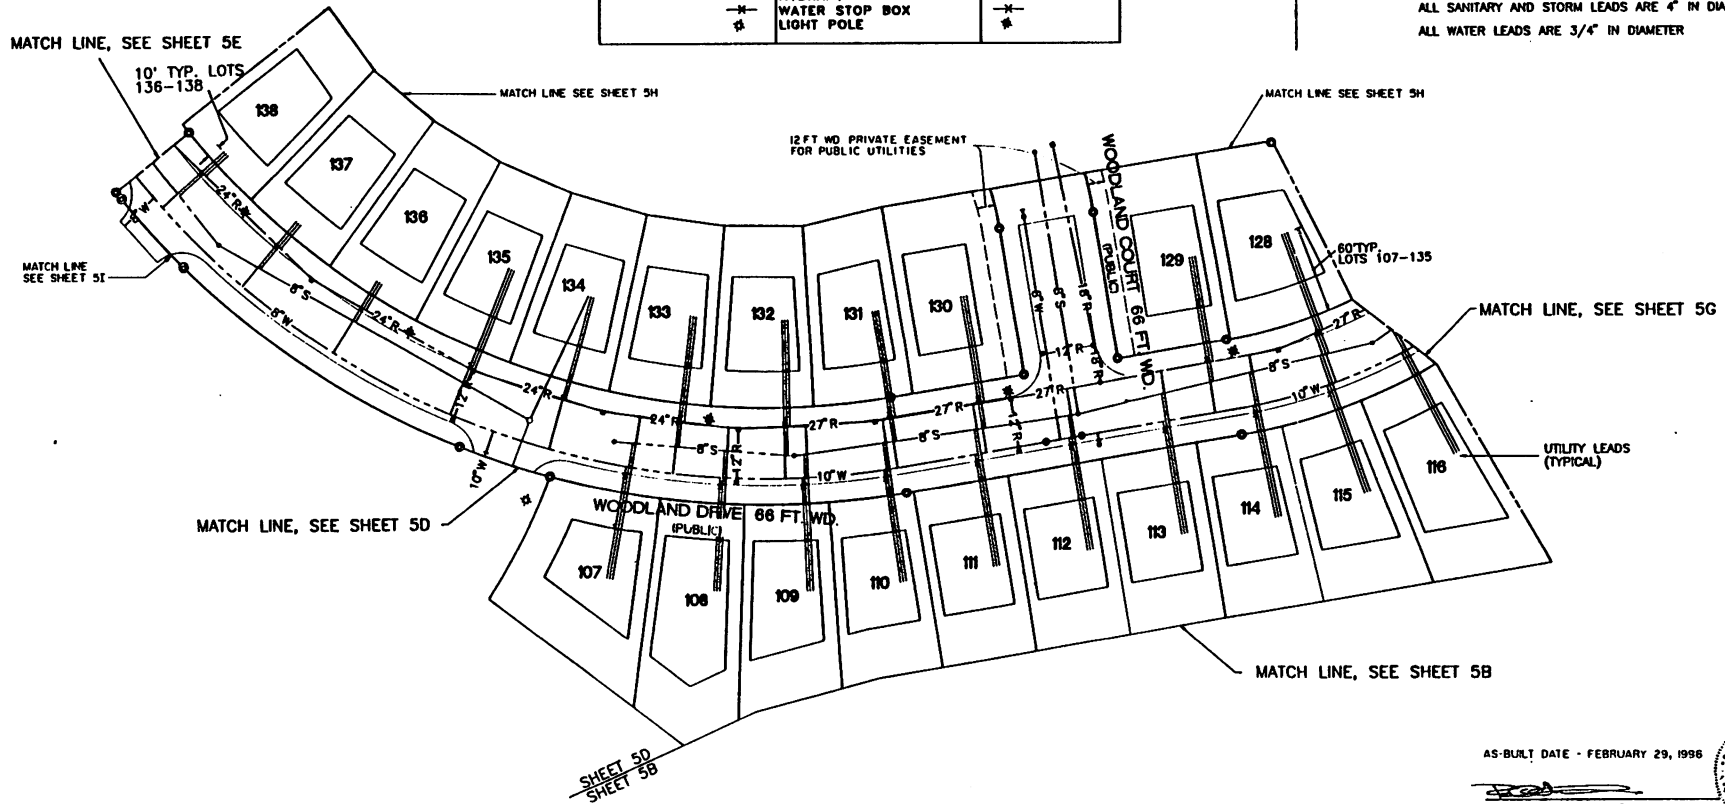

UTILITY PLAN
 PHASE 3B (UNITS 107-116
 and 128-138)
 NORTHVIEW

AS-BUILT DATE - FEBRUARY 29, 1996


ROBERT G. MACOMBER
 PROFESSIONAL SURVEYOR NO. 27453
 ATWELL-HICKS, INC.
 540 AVIS DRIVE
 ANN ARBOR, MICHIGAN 48108
 TELEPHONE - (313) 994-4000



5F

CLIENT: PETERS BUILDING COMPANY	SECTION 36 TOWN 3 SOUTH, RANGE 3 EAST CITY OF SALINE WASHINGTON COUNTY, MICHIGAN	ATWELL-HICKS, INC. CIVIL ENGINEERS, SURVEYORS, PLANNERS LAND ARCHITECTS (313) 994-4000
	DATE: 2-29-96 BY: RHM CHECKED: JON 00386.31	PROJECT NO: 138-195F

LIBRARY
 PAGE 60 OF 67
 COPY

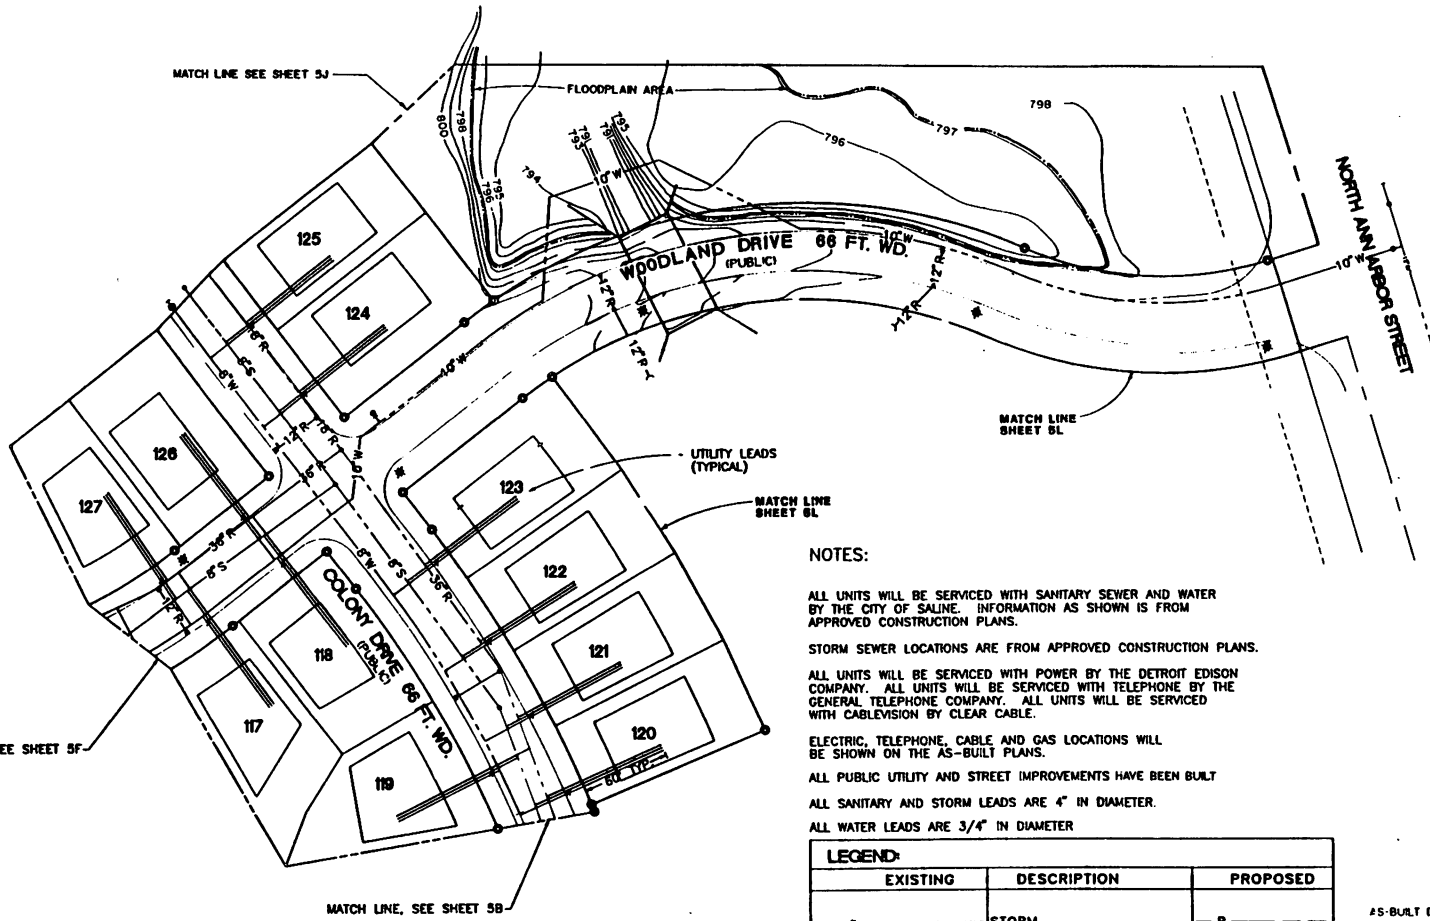

NOTES:

ALL UNITS WILL BE SERVICED WITH SANITARY SEWER AND WATER BY THE CITY OF SALINE. INFORMATION AS SHOWN IS FROM APPROVED CONSTRUCTION PLANS.

STORM SEWER LOCATIONS ARE FROM APPROVED CONSTRUCTION PLANS.

ALL UNITS WILL BE SERVICED WITH POWER BY THE DETROIT EDISON COMPANY. ALL UNITS WILL BE SERVICED WITH TELEPHONE BY THE GENERAL TELEPHONE COMPANY. ALL UNITS WILL BE SERVICED WITH CABLEVISION BY CLEAR CABLE.

ELECTRIC, TELEPHONE, CABLE AND GAS LOCATIONS WILL BE SHOWN ON THE AS-BUILT PLANS.

ALL PUBLIC UTILITY AND STREET IMPROVEMENTS HAVE BEEN BUILT

ALL SANITARY AND STORM LEADS ARE 4" IN DIAMETER.

ALL WATER LEADS ARE 3/4" IN DIAMETER

LEGEND:		
EXISTING	DESCRIPTION	PROPOSED
— / —	STORM	R — — —
— Δ —	SANITARY	S — — —
— W —	WATER	W — — —
— U —	UNDERGROUND ELECTRIC	UE — — —
— G —	GAS	G — — —
— UT —	UNDERGROUND TELEPHONE	UT — — —
○	MANHOLE	○
■	CATCH BASIN	■
— H —	HYDRANT	— H —
— X —	WATER STOP BOX	— X —
☆	LIGHT POLE	☆

AS-BUILT DATE - FEBRUARY 23, 1998



ROBERT G. MACOMBER
 PROFESSIONAL SURVEYOR NO. 27453
 ATWELL-HICKS, INC.
 340 AVIS DRIVE
 ANN ARBOR, MICHIGAN 48108
 TELEPHONE - (313) 994-4000


**UTILITY PLAN
 PHASE 3B (UNITS 117-127)
 NORTHVIEW**

5G

CLIENT: PETERS BUILDING COMPANY	SECTION 34 TOWN 5 SOUTH, RANGE 9 EAST	ATWELL-HICKS, INC. CIVIL ENGINEER/SURVEYOR, PLANNERS ANN ARBOR, MICHIGAN (313) 994-4000
	CITY OF SALINE WASHINGTON COUNTY, MICHIGAN	DATE 2-29-98
		SCALE 1" = 40' FEET
		138-195G

LIBRARY
 053207 Page 06 of 67
 COPY

LEGEND		
EXISTING	DESCRIPTION	PROPOSED
—▲—	SANITARY SEWER	—S—
—▲—	STORM SEWER	—R—
—W—	WATER MAIN	—W—
—G—	GAS MAIN	—G—
—E—	UNDERGROUND ELECTRIC	—E—
—T—	UNDERGROUND TELEPHONE	—T—
—C—	UNDERGROUND CABLEVISION	—C—
○	SANITARY MANHOLE	●
○	CATCHBASIN	●
○	WATER VALVE	●
○	HYDRANT	●
○	METER LOCATION	○
□	TRANSFORMER	□
□	WATER LEAD STOP BOX	□
+	LIGHT POLE	+

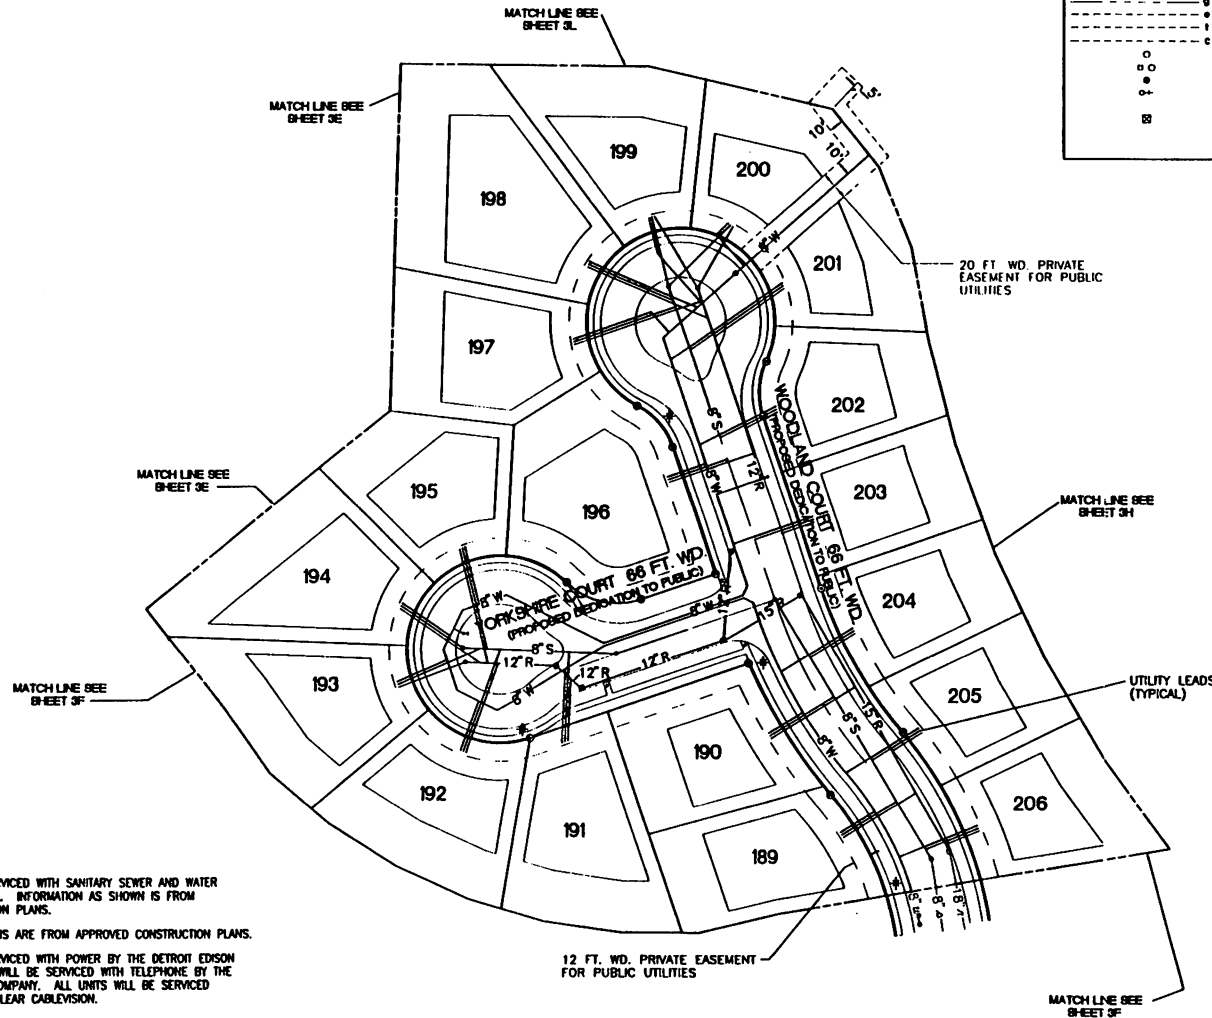

AS BUILT DATE - FEBRUARY 29, 1996
Bruce C. Wallace
 BRUCE C. WALLACE
 LICENSED PROFESSIONAL ENGINEER NO. 39722
 ATWELL-HICKS, INC.
 540 AVIS DRIVE
 ANN ARBOR, MICHIGAN 48108
 TELEPHONE - (313) 994-4000

GENERAL NOTES

- ALL UNITS WILL BE SERVICED WITH SANITARY SEWER AND WATER BY THE CITY OF SALINE. INFORMATION AS SHOWN IS FROM APPROVED CONSTRUCTION PLANS.
- STORM SEWER LOCATIONS ARE FROM APPROVED CONSTRUCTION PLANS.
- ALL UNITS WILL BE SERVICED WITH POWER BY THE DETROIT EDISON COMPANY. ALL UNITS WILL BE SERVICED WITH TELEPHONE BY THE GENERAL TELEPHONE COMPANY. ALL UNITS WILL BE SERVICED WITH CABLEVISION BY CLEAR CABLEVISION.
- ALL PUBLIC UTILITIES AND STREET IMPROVEMENTS HAVE BEEN BUILT.
- ALL SANITARY AND STORM LEADS ARE 4" IN DIAMETER.
- ALL WATER LEADS ARE 1" IN DIAMETER.

**UTILITY PLAN
 PHASE 5 (UNITS 189-206)
 NORTHVIEW**

5H

CLIENT: PETERS BUILDING COMPANY	SECTION 36 TOWN 3 SOUTH RANGE 3 EAST CITY OF SALINE WASHTENAW COUNTY, MICHIGAN	ATWELL-HICKS, INC. CIVIL ENGINEERS, SURVEYORS, PLANNERS ANN ARBOR (313) 994-4000
DATE: 2/29/1996	SCALE: 1 INCH = 40 FEET	DATE: 2/29/1996
		138-195H

LIBERT 05320 Page 0692
 PAGE 62 OF 67
 COPY

NORTHVIEW CONDOMINIUM
PHASE 3B

NORTHVIEW CONDOMINIUM
PHASE 3A

GENERAL NOTES

ALL UNITS WILL BE SERVICED WITH SANITARY SEWER AND WATER BY THE CITY OF SALINE. INFORMATION AS SHOWN IS FROM APPROVED CONSTRUCTION PLANS.

SANITARY SEWER LOCATIONS ARE FROM APPROVED CONSTRUCTION PLANS.

ALL UNITS WILL BE SERVICED WITH POWER BY THE DETROIT EDISON COMPANY. ALL UNITS WILL BE SERVICED WITH TELEPHONE BY THE GENERAL TELEPHONE COMPANY. ALL UNITS WILL BE SERVICED WITH CABLEVISION BY CLEAR CABLEVISION.

ALL PUBLIC UTILITIES AND STREET IMPROVEMENTS HAVE BEEN BUILT.

ALL SANITARY AND STORM LEADS ARE 4" IN DIAMETER.

ALL WATER LEADS ARE 1" IN DIAMETER.

EXISTING	DESCRIPTION	PROPOSED
---	SANITARY SEWER	-S-
---	STORM SEWER	-R-
---	WATER MAIN	-W-
---	GAS MAIN	-G-
---	UNDERGROUND ELECTRIC	-L-E-
---	UNDERGROUND TELEPHONE	-L-T-
---	UNDERGROUND CABLEVISION	-L-C-
○	SANITARY MANHOLE	○
○	CATCHBASIN	○
○	WATER VALVE	○
+	HYDRANT	+
+	METER LOCATION	+
+	TRANSFORMER	+
+	WATER LEAD STOP BOX	+
+	LIGHT POLE	+

MATCH LINE
SEE SHEET 3E

UTILITY LEADS
(TYPICAL)

MATCH LINE
SEE SHEET 3D

20' WIDE EASEMENT FOR
PRIVATE STORM EASEMENT
N 16°11'46" E 181.32

20' WIDE EASEMENT FOR
PRIVATE STORM EASEMENT
N 09°31'25" E 173.49

20 FT. WIDE PRIVATE
EASEMENT FOR
PUBLIC UTILITIES

25.00'

17.5 FT. WIDE PRIVATE
EASEMENT FOR PUBLIC
UTILITIES

NORTHVIEW CONDOMINIUM
PARK AREA
PHASE 3B

NORTHVIEW CONDOMINIUM
PHASE 2

MATCH LINE
SEE SHEET 3C

WEST LINE SEC. 36, T3S, R5E

17 FT. WD. PRIVATE
EASEMENT FOR PUBLIC
UTILITIES

17 FT. WD. PRIVATE
EASEMENT FOR PUBLIC
UTILITIES

**UTILITY PLAN
PHASE 4 (UNITS 157-188 AND UNITS 249-251)
NORTHVIEW**

5 I



AS-BUILT DATE - FEBRUARY 28, 1996
Bruce C. Wallace
BRUCE C. WALLACE
LICENSED PROFESSIONAL ENGINEER NO. 39722
ATWELL-HICKS, INC.
540 AHS DRIVE
ANN ARBOR, MICHIGAN 48108
TELEPHONE - (313) 994-4000

CLIENT: PETERS BUILDING COMPANY

SECTION 36 TOWNSHIP 3 SOUTH, RANGE 5 EAST
CITY OF SALINE
WASHTENAW COUNTY, MICHIGAN

ATWELL-HICKS, INC.
CIVIL ENGINEERS, SURVEYORS, PLANNERS
ANN ARBOR (810) 964-4000

DATE: 02/19/96
SCALE: 1" = 40' FEET
DRAWN BY: [Signature]

DATE: 02/19/96
JOB: 90299.02
138-1951

LIBER 03320
PAGE 69 OF 67
0693

GENERAL NOTES

ALL UNITS WILL BE SERVICED WITH SANITARY SEWER AND WATER BY THE CITY OF SALINE. INFORMATION AS SHOWN IS FROM APPROVED CONSTRUCTION PLANS.

STORM SEWER LOCATIONS ARE FROM APPROVED CONSTRUCTION PLANS.


ALL UNITS WILL BE SERVICED WITH POWER BY THE DETROIT EDISON COMPANY. ALL UNITS WILL BE SERVICED WITH TELEPHONE BY THE GENERAL TELEPHONE COMPANY. ALL UNITS WILL BE SERVICED WITH CABLEVISION BY CLEAR CABLEVISION.

ALL PUBLIC UTILITIES AND STREET IMPROVEMENTS HAVE BEEN BUILT.

ALL SANITARY AND STORM LEADS ARE 4" IN DIAMETER.

ALL WATER LEADS ARE 1" IN DIAMETER.

EXISTING	DESCRIPTION	PROPOSED
---	SANITARY SEWER	-S
---	STORM SEWER	-R
---	WATER MAIN	-W
---	GAS MAIN	-G
---	UNDERGROUND ELECTRIC	-E
---	UNDERGROUND TELEPHONE	-T
---	UNDERGROUND CABLEVISION	-C
○	SANITARY MANHOLE	●
○	CATCHBASIN	●
○	WATER VALVE	+
○	HYDRANT	+
○	METER LOCATION	+
○	TRANSFORMER	+
○	WATER LEAD STOP BOX	○
○	LIGHT POLE	+

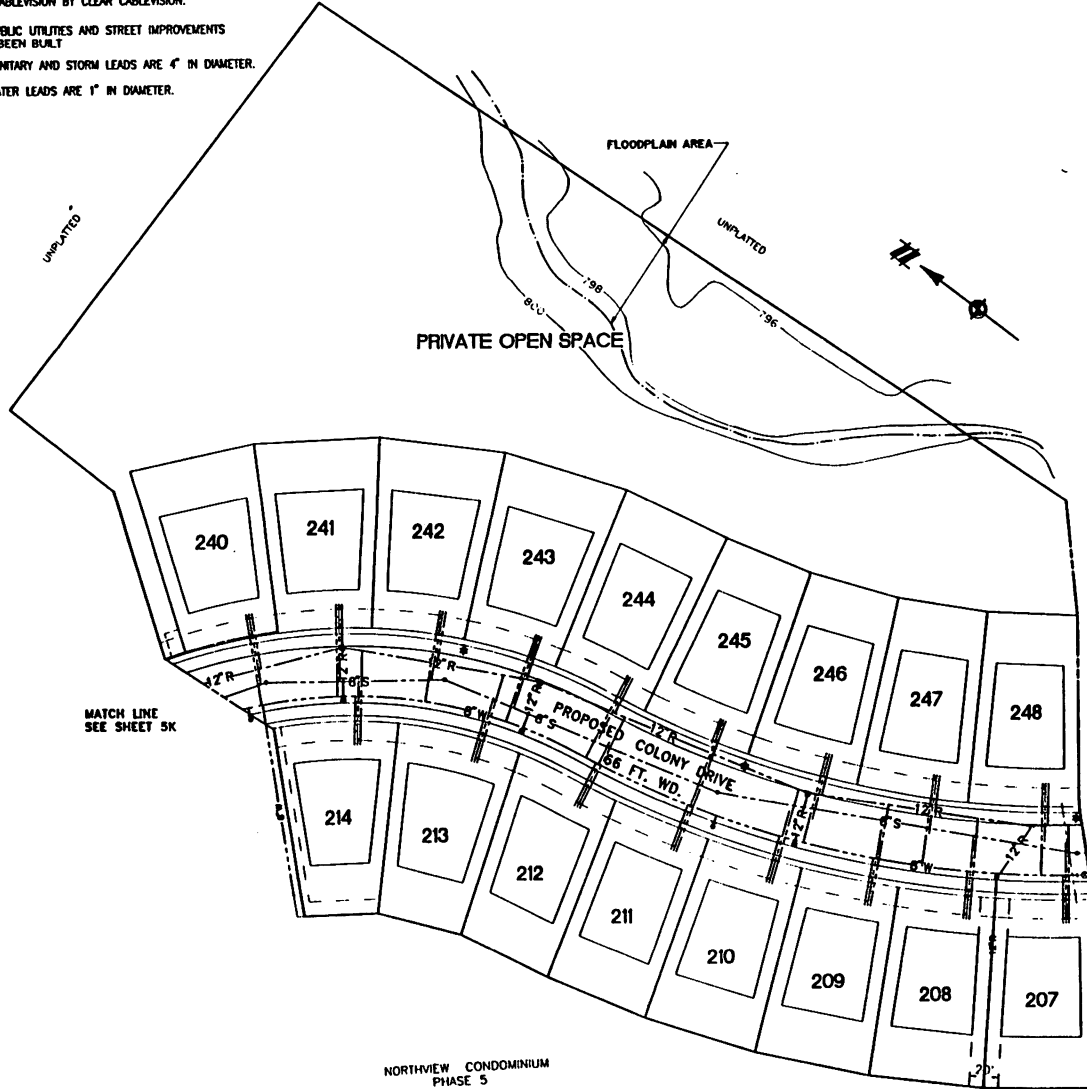

NORTHVIEW PHASE 3B (EXISTING)

MATCH LINE SEE SHEET 5G

NORTHVIEW CONDOMINIUM PHASE 5

MATCH LINE SEE SHEET 5H

MATCH LINE SEE SHEET 5K

AS-BUILT DATE - FEBRUARY 29, 1998




Bruce C. Wallace
 BRUCE C. WALLACE
 LICENSED PROFESSIONAL ENGINEER NO. 39722
 ATWELL-HICKS, INC.
 540 AVIS DRIVE
 ANN ARBOR, MICHIGAN 48108
 TELEPHONE - (313) 994-4000

**UTILITY AND FLOODPLAIN PLAN
 PHASE 6 (UNITS 207-214 AND UNITS 240-248)
 NORTHVIEW**

5J

CLIENT: PETERS BUILDING COMPANY	SECTION 36 TOWN 3 SOUTH, RANGE 3 EAST CITY OF SALINE WASHTENAW COUNTY, MICHIGAN	ATWELL-HICKS, INC. CIVIL ENGINEERS, SURVEYORS, PLANNERS ANN ARBOR (313) 994-4000
	DATE: 2/28/1998	FILE NO: 158-195J
	SCALE: 1" = 40' FEET CONVERSION IN FEET	

LIBRARY
 03320 Page 0694
 Page 64 of 67
 COPY

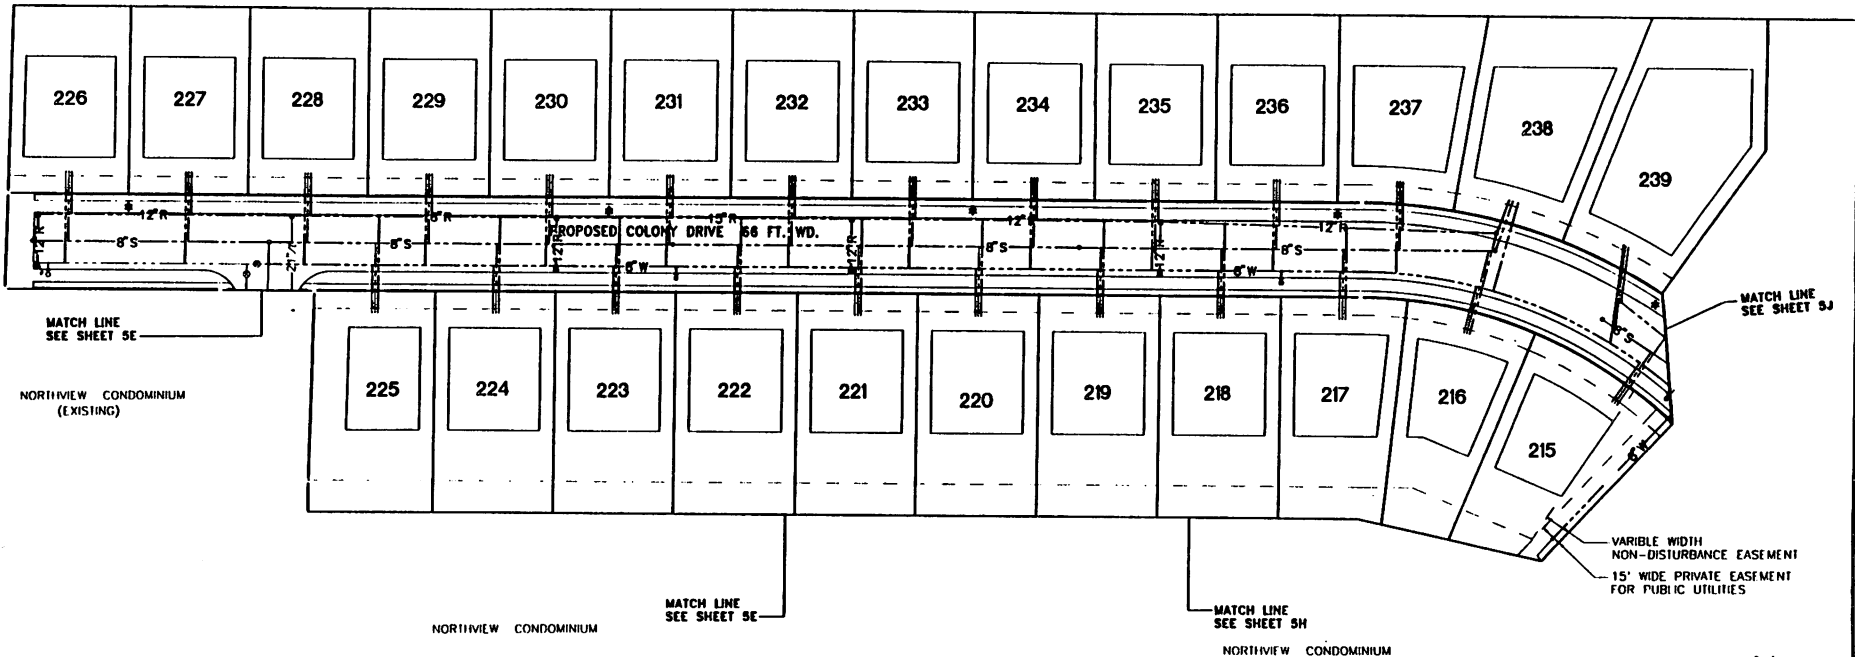

AS-BUILT DATE - FEBRUARY 29, 1998

Bruce C. Wallace

BRUCE C. WALLACE
LICENSED PROFESSIONAL ENGINEER NO. 39722
ATWELL-HICKS, INC.
540 AVIS DRIVE
ANN ARBOR, MICHIGAN 48106
TELEPHONE - (313) 994-4000

LEGEND		
EXISTING	DESCRIPTION	PROPOSED
---	SANITARY SEWER	-S-
---	STORM SEWER	-R-
---	WATER MAIN	-W-
---	GAS MAIN	-G-
---	UNDERGROUND ELECTRIC	-E-
---	UNDERGROUND TELEPHONE	-T-
---	UNDERGROUND CABLEVISION	-C-
○	SANITARY MANHOLE	●
○	CATCHBASIN	●
●	WATER VALVE	●
○	HYDRANT	●
⊗	METER LOCATION	⊗
⊗	TRANSFORMER	⊗
⊗	WATER LEAD STOP BOX	⊗
○	LIGHT POLE	⊕

GENERAL NOTES

ALL UNITS WILL BE SERVICED WITH SANITARY SEWER AND WATER BY THE CITY OF SALINE. INFORMATION AS SHOWN IS FROM APPROVED CONSTRUCTION PLANS.

STORM SEWER LOCATIONS ARE FROM APPROVED CONSTRUCTION PLANS.

ALL UNITS WILL BE SERVICED WITH POWER BY THE DETROIT EDISON COMPANY. ALL UNITS WILL BE SERVICED WITH TELEPHONE BY THE GENERAL TELEPHONE COMPANY. ALL UNITS WILL BE SERVICED WITH CABLEVISION BY CLEAR CABLEVISION.

ALL PUBLIC UTILITIES AND STREET IMPROVEMENTS HAVE BEEN BUILT.

ALL SANITARY AND STORM LEADS ARE 4" IN DIAMETER.

ALL WATER LEADS ARE 1" IN DIAMETER.

**UTILITY PLAN
PHASE 6 (UNITS 215-239)
NORTHVIEW**

5K

CLIENT: PETERS BUILDING COMPANY	SECTION 36 TOWN 3 SOUTH, RANGE 5 EAST CITY OF SALINE WASHINGTON COUNTY, MICHIGAN	ATWELL-HICKS, INC. CIVIL ENGINEERS, SURVEYORS, PLANNERS ANN ARBOR MI 48106 (313) 994-4000
DATE: 02/22/98	SCALE: 1" = 40' PER 1" IN PLOT	138-195K

LIBERT 03320 PAGE 0699
PAGE 65 OF 67
COPY




GENERAL NOTES

ALL UNITS WILL BE SERVICED WITH SANITARY SEWER AND WATER BY THE CITY OF SALINE. INFORMATION AS SHOWN IS FROM APPROVED CONSTRUCTION PLANS.

ALL UNITS WILL BE SERVICED WITH POWER BY THE DETROIT EDISON COMPANY. ALL UNITS WILL BE SERVICED WITH TELEPHONE BY THE GENERAL TELEPHONE COMPANY. ALL UNITS WILL BE SERVICED WITH CABLEVISION BY CLEAR CABLEVISION.

ALL PUBLIC UTILITIES AND STREET IMPROVEMENTS HAVE BEEN BUILT. ALL SANITARY AND STORM LEADS ARE 4" IN DIAMETER. ALL WATER LEADS ARE 1" IN DIAMETER.

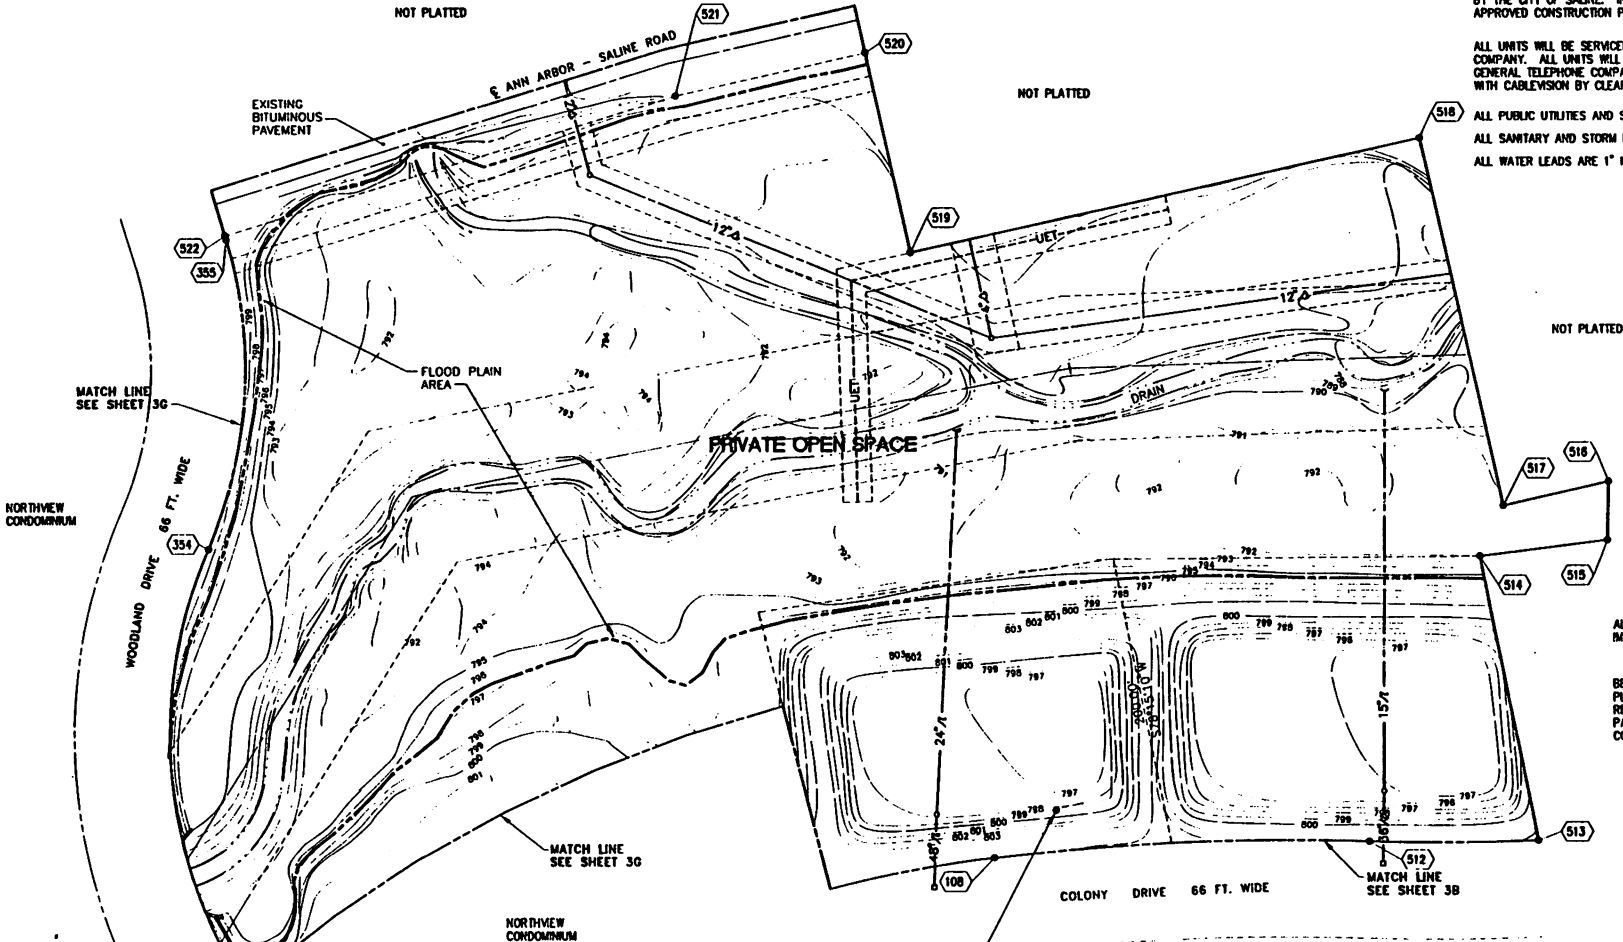

ALL PUBLIC STREET AND UTILITY IMPROVEMENTS HAVE BEEN BUILT

BEARINGS ARE RELATED TO THE PLAT OF COLONY ESTATES AS RECORDED IN LIBER 21 OF PLATS, PAGES 84-86, WASHTENAW COUNTY RECORDS.

LEGEND		
EXISTING	DESCRIPTION	PROPOSED
—▲—	SANITARY SEWER	—S—
—▽—	STORM SEWER	—R—
—W—	WATER MAIN	—W—
—G—	GAS MAIN	—G—
—E—	UNDERGROUND ELECTRIC	—E—
—T—	UNDERGROUND TELEPHONE	—T—
—C—	UNDERGROUND CABLEVISION	—C—
○	SANITARY MANHOLE	●
○	CATCHBASIN	○
○	WATER VALVE	○
○	HYDRANT	○
○	METER LOCATION	○
○	TRANSFORMER	○
○	WATER LEAD STOP BOX	○
○	LIGHT POLE	○

BENCHMARK: SPINDLE IN NW FACE OF 1ST FLW OF ELEV. 799.75 CITY OF SALINE DATUM

AS-BUILT - FEBRUARY 29, 1996

Bruce C. Wallace

BRUCE C. WALLACE
LICENSED PROFESSIONAL ENGINEER NO. 39722
ATWELL-HICKS, INC.
540 AHS DRIVE
ANN ARBOR, MICHIGAN 48106
TELEPHONE - (313) 994-4000



**UTILITY PLAN
PRIVATE OPEN SPACE
NORTHVIEW**


5L

CLIENT: PETERS BUILDING COMPANY	SECTION 36 TOWN 5 SOUTH, RANGE 5 EAST	ATWELL-HICKS, INC. CIVIL ENGINEERS, SURVEYORS, PLANNERS AND ARCHITECTS EST. 1924
CITY OF SALINE, MICHIGAN	WASHTENAW COUNTY, MICHIGAN	DATE: 02/27/96
SCALE: 1" = 40' FEET	DATE: 02/27/96	138-195L

LIBER 03320 Page 0696
COPY PAGE 66 OF 67

UNIT NO.	BASE ELEV.
243	821.7
242	818.1
245	812.0
246	809.1
247	804.3
248	799.2
249	798.1
250	797.3
251	796.6
252	796.1

UNIT NO.	BASE ELEV.	UNIT NO.	BASE ELEV.	UNIT NO.	PAGE ELEV.
1	786.3	80	790.5	165	803.8
2	786.3	81	791.9	166	804.6
3	786.2	82	791.0	167	802.9
4	786.2	83	790.1	168	800.0
5	786.2	84	790.0	169	800.0
6	789.2	85	790.6	170	799.0
7	789.2	86	790.6	171	797.8
8	789.2	87	790.5	172	796.4
9	789.8	88	790.5	173	809.2
10	789.4	89	791.1	174	808.7
11	787.0	90	791.8	175	808.2
12	787.0	91	794.5	176	807.9
13	787.0	92	794.5	177	807.5
14	789.8	93	794.0	178	806.8
15	789.8	94	794.0	179	806.3
16	789.8	95	794.5	180	805.8
17	789.8	96	794.5	181	804.8
18	791.2	97	794.0	182	804.0
19	791.2	98	793.5	183	803.1
20	791.2	99	792.1	184	801.2
21	791.2	100	792.0	185	800.4
22	791.5	101	793.0	186	800.2
23	793.2	102	795.4	187	798.8
24	793.2	103	796.4	188	798.9
25	793.0	104	797.1	189	798.9
26	792.9	105	797.7	189	802.8
27	792.9	106	798.5	191	814.8
28	792.9	107	802.0	192	815.8
29	792.9	108	801.3	193	819.3
30	792.9	109	800.7	194	819.6
31	792.9	110	800.2	195	819.8
32	792.9	111	799.3	196	819.8
33	792.9	112	798.2	197	817.3
34	792.9	113	797.0	198	817.3
35	792.9	114	795.8	199	816.9
36	792.9	115	794.8	200	816.6
37	792.9	116	793.9	201	816.6
38	792.9	117	793.7	202	816.6
39	792.9	118	794.1	203	816.6
40	792.9	119	793.3	204	816.6
41	792.9	120	793.2	205	816.6
42	794.7	121	793.2	206	789.0
43	794.7	122	793.2	207	789.0
44	794.7	123	792.2	208	789.0
45	794.7	124	792.2	209	805.2
46	792.9	125	791.8	210	808.6
47	792.9	126	791.4	211	811.5
48	792.9	127	791.4	212	812.9
49	792.9	128	794.8	213	823.8
50	792.9	129	794.8	214	823.8
51	792.9	130	799.2	215	832.6
52	798.8	131	800.9	216	832.8
53	797.6	132	800.9	217	831.1
54	797.6	133	801.6	218	829.2
55	797.6	134	803.0	219	827.5
56	798.5	135	805.0	220	825.6
57	798.5	136	807.2	221	823.8
58	798.5	137	809.5	222	820.4
59	798.5	138	811.8	223	820.4
60	798.5	139	812.9	224	819.7
61	798.5	140	812.9	225	817.0
62	798.5	141	812.9	226	817.0
63	798.5	142	811.0	227	814.0
64	798.5	143	811.0	228	812.9
65	798.5	144	812.9	229	816.7
66	798.5	145	816.0	230	816.7
67	798.5	146	817.7	231	811.0
68	798.5	147	817.7	232	822.6
69	798.5	148	818.5	233	824.6
70	796.2	149	818.2	234	824.6
71	796.2	150	818.2	235	826.5
72	796.2	151	821.5	236	828.7
73	795.6	152	823.5	237	830.1
74	795.2	153	823.7	238	832.0
75	794.7	154	824.9	239	832.9
76	794.7	155	827.1	240	832.7
77	793.8	156	830.8	241	830.8
78	793.8	157	832.5	242	829.5
79	793.8	158	835.7	243	825.3

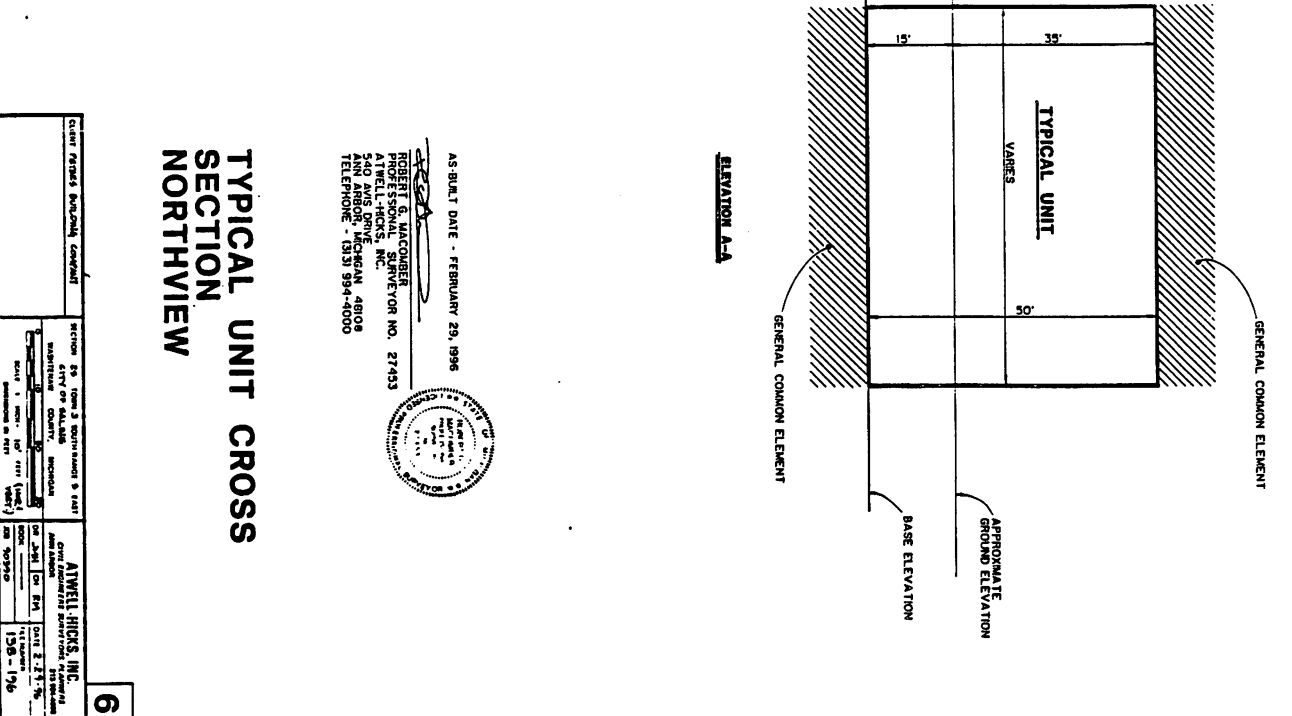

AS SUBMIT DATE - FEBRUARY 29, 1966

ROBERT E. HATZDORFER
 PROFESSIONAL SURVEYOR NO. 27433
 ATTORNEY-AT-LAW
 540 AVIS DRIVE
 CECILIAN, ARIZONA
 TELEPHONE - (520) 394-4000

ATYRELL HICKS, INC.
 CIVIL ENGINEER
 136-196

RECEIVED
 STATE OF ARIZONA
 BOARD OF SURVEYORS
 FEB 29 1966

TYPICAL UNIT CROSS SECTION NORTHVIEW


CLIENT: FRIED'S BUILDING COMPANY	
SECTION: 89	DATE: 2/29/66
CITY: PHOENIX	COUNTY: MARICOPA
PROJECT: CIVIL ENGINEERING	SCALE: 1/8" = 1'-0"
DRAWN BY: J.E.H.	CHECKED BY: J.E.H.

6

copy

LET OF 10 6/1

PHEN 394-4000

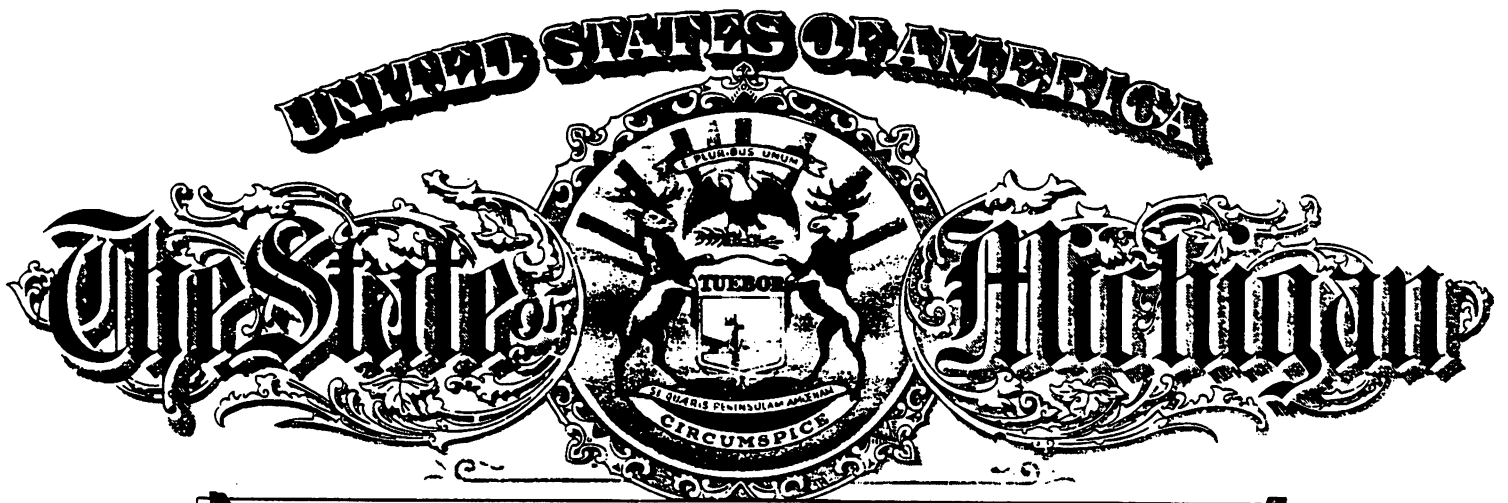

Michigan Department of Commerce

Lansing, Michigan

This is to Certify That Articles of Incorporation of

SALINE NORTHVIEW CONDOMINIUM ASSOCIATION

were duly filed in this office on the 15TH day of APRIL, 1988,

in conformity with Act 162, Public Acts of 1982.

In testimony whereof, I have hereunto set my hand and affixed the Seal of the Department, in the City of Lansing, this 15TH day of APRIL, 1988.

Doug Rose Director

RECEIVED

FILED

APR 14 1988

NON-PROFIT

APR 15 1988

MICHIGAN DEPT. OF COMMERCE

ARTICLES OF INCORPORATION

Administrator
MICHIGAN DEPARTMENT OF COMMERCE
Corporation & Securities Bureau

These Articles of Incorporation are signed by the incorporator for the purpose of forming a non-profit corporation under the provisions of Act No. 162 of the Public Acts of 1982, as amended, as follows:

729 225

ARTICLE I.

The name of the corporation is Saline Northview Condominium Association.✓

ARTICLE II.

The purpose or purposes for which the Association is formed are as follows:

- (a) To manage and administer the affairs of and to maintain Northview, a condominium (hereinafter called the "Condominium");
- (b) To levy and collect assessments against and from the members of the Association and to use the proceeds thereof for the purposes of the Association, to enforce assessments through liens and foreclosure proceedings when appropriate, and to impose late charges for nonpayment of assessments;
- (c) To carry insurance and to collect and allocate the proceeds thereof;
- (d) To rebuild improvements to the common elements after casualty;
- (e) To contract for and employ persons, firms or corporations to assist in the management, operation, maintenance, and administration of said Condominium;
- (f) To make reasonable rules and regulations governing the use and enjoyment of the Condominium by members and their tenants, guests, employees, invitees, families and pets and to enforce such rules and regulations by all legal methods, including, without limitation, imposing fines and late payment charges, or instituting eviction or legal proceedings;

- (g) To own, maintain and improve, and to buy, sell, convey, assign, mortgage, or lease (as landlord or tenant) any real and personal property, or any interest therein, including, but not limited to, any unit in the Condominium, any easements or licenses or any other real property, whether or not contiguous to the Condominium, for the purpose of providing benefit to the members of the Association and in furtherance of any of the purposes of the Association;
- (h) To borrow money and issue evidences of indebtedness in furtherance of any or all of the objects of its business; to secure the same by mortgage, pledge or other lien;
- (i) To enforce the provisions of the Master Deed and By-Laws of the Condominium and of these Articles of Incorporation and such By-Laws and Rules and Regulations of the Association as may hereafter be adopted;
- (j) To do anything required of or permitted to it as Administrator of said Condominium by the Condominium Master Deed or By-Laws or by Act No. 59 of Public Acts of 1978, as from time to time amended;
- (k) In general, to enter into any kind of activity, to make and perform any contract and to exercise all powers necessary, incidental or convenient to the administration, management, maintenance, repair, replacement, and operation of said Condominium and to the accomplishment of any of the purposes thereof.

ARTICLE III.

Said Association is organized upon a non-stock membership basis.

The amount of assets which said Association possesses is:

Real Property	None
Personal Property	None

Said Association is to be financed under the following general plan:

Assessment of Members

ARTICLE IV.

Location of the first registered office is: 203 West Michigan Avenue, Saline, Michigan 48176.

Post office address of the first registered office is: 203 West Michigan Avenue, Saline, Michigan 48176.

The name of the first resident agent is: Paul J. Peters.

ARTICLE V.

The name and place of business of the incorporator is as follows:

Karl R. Frankena 700 City Center Building
Ann Arbor, Michigan 48104

ARTICLE VI.

Any action required or permitted to be taken at an annual or special meeting of members may be taken without a meeting, without prior notice and without a vote, if a consent in writing, setting forth the action so taken, is signed by members having not less than the minimum number of votes that would be necessary to authorize or take the action at a meeting at which all members entitled to vote therein were present and voted. Prompt notice of the taking of the corporate action without a meeting by less than unanimous written consent shall be given to members who have not consented in writing.

ARTICLE VII.

The qualifications of members, the manner of their admission to the Association, the termination of membership, and voting by such members shall be as follows:

- (a) Each co-owner (including the Developer) of a unit in the Condominium shall be a member of the Association, and no other person or entity shall be entitled to membership.
- (b) Membership in the Association shall be established by acquisition of fee simple title to a unit in the Condominium, or purchase of a unit on a land contract, and by recording with the Register of Deeds of Washtenaw County, Michigan, a deed or other instrument establishing a change of record title to such condominium unit and the furnishing of evidence of same satisfactory to the Association (except that the Developer of the Condominium shall become a member immediately upon establishment of the Condominium), the new co-owner thereby becoming a member of the Association, and the membership of the prior co-owner thereby being terminated.
- (c) The share of a member in the funds and assets of the Association cannot be assigned, pledged, encumbered, or

transferred in any manner except as an appurtenance to his unit in the Condominium.

- (d) Voting by members shall be in accordance with the provisions of the By-Laws of the Association.

ARTICLE VIII.

A volunteer director shall not be personally liable to the Association or its co-owners for monetary damages for breach of the director's fiduciary duty, except where there is:

- (a) A breach of the director's duty of loyalty to the Association or its co-owners;
- (b) Acts or omissions not in good faith or that involve intentional misconduct or a knowing violation of law;
- (c) A violation of Michigan Statutes Annotated Section 21.200(551);
- (d) A transaction from which the director derived an improper personal benefit; or
- (e) An act or omission that is grossly negligent.

If the Michigan Nonprofit Corporation Act is subsequently amended to authorize corporate action further eliminating or limiting the personal liability of directors, then the liability of a director of the Association shall be eliminated or limited to the fullest extent permitted by the Michigan Nonprofit Corporation Act, as so amended.

Any repeal or modification of the foregoing provisions of this Article by the co-owners of the Association shall not adversely affect any right or protection of a director of the Association existing at the time of such repeal or modification.

ARTICLE IX.

These Articles of Incorporation may be amended, altered, changed, or repealed only by the affirmative vote of not less than seventy-five (75%) percent of the entire membership of the Association; provided, that in no event shall any amendment make changes in the qualification for membership or the voting rights of members without the unanimous consent of the membership.

I, the incorporator, sign my name this 13th day of April, 1988.



KARL R. FRANKENA